



WALWORTH COUNTY  
SURVEYING & MAPPING  
LAKE GENEVA, WISCONSIN

BAY VIEW AVENUE

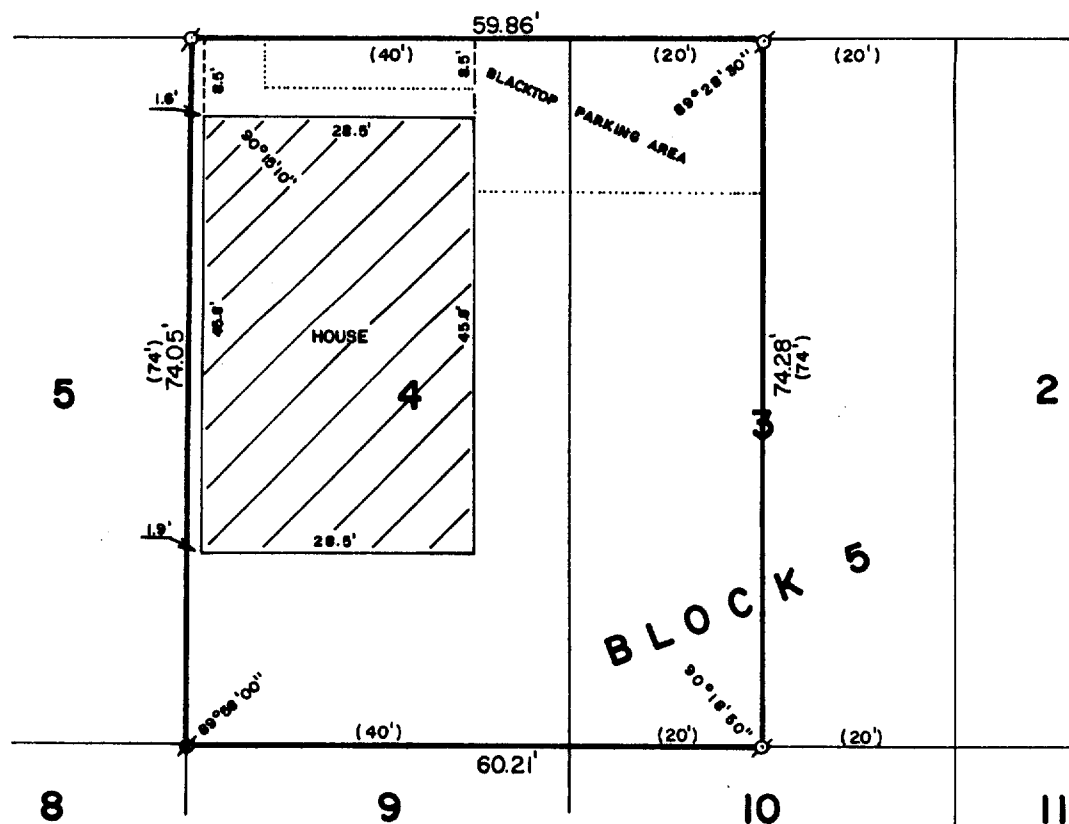


PLAT OF SURVEY OF

THE WEST 20 FEET OF LOT 3 AND ALL OF LOT  
4, BLOCK 5 OF D. A. REIDS ADDITION TO REIDS  
PARK, LOCATED IN THE VILLAGE OF FONTANA-ON-  
GENEVA LAKE, WALWORTH COUNTY, WISCONSIN.

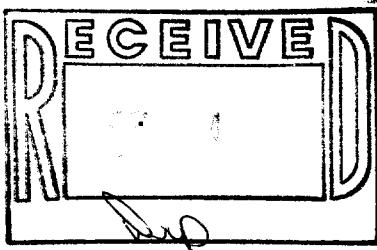

ORDERED BY: JERRY WILKE  
400 S. MILWAUKEE  
WHEELING, ILLINOIS 60090

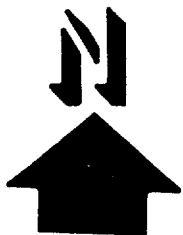

SCALE: 1"=30

⊙ - IRON PIPE FOUND  
● - CONCRETE MONUMENT FOUND  
( ) - RECORDED AS

I, ROBERT M. BAERENWALD, DO HEREBY CERTIFY THAT I  
HAVE SURVEYED THE PROPERTY HEREON DESCRIBED ACCORDING  
TO THE OFFICIAL RECORDS AND THAT THE PLAT HEREON IS A  
CORRECT REPRESENTATION OF THE PROPERTY LINES TO THE  
BEST OF MY KNOWLEDGE AND BELIEF.

*Robert M. Baerenwald*  
ROBERT M. BAERENWALD  
WISCONSIN REGISTERED LAND SURVEYOR, S-1508

*Dec. 15, 1986*  
DATE JOB NO. 0857

NOTE: THIS IS NOT A CERTIFIED COPY UNLESS SEALED.