


RECEIVED
MAR 5 1967

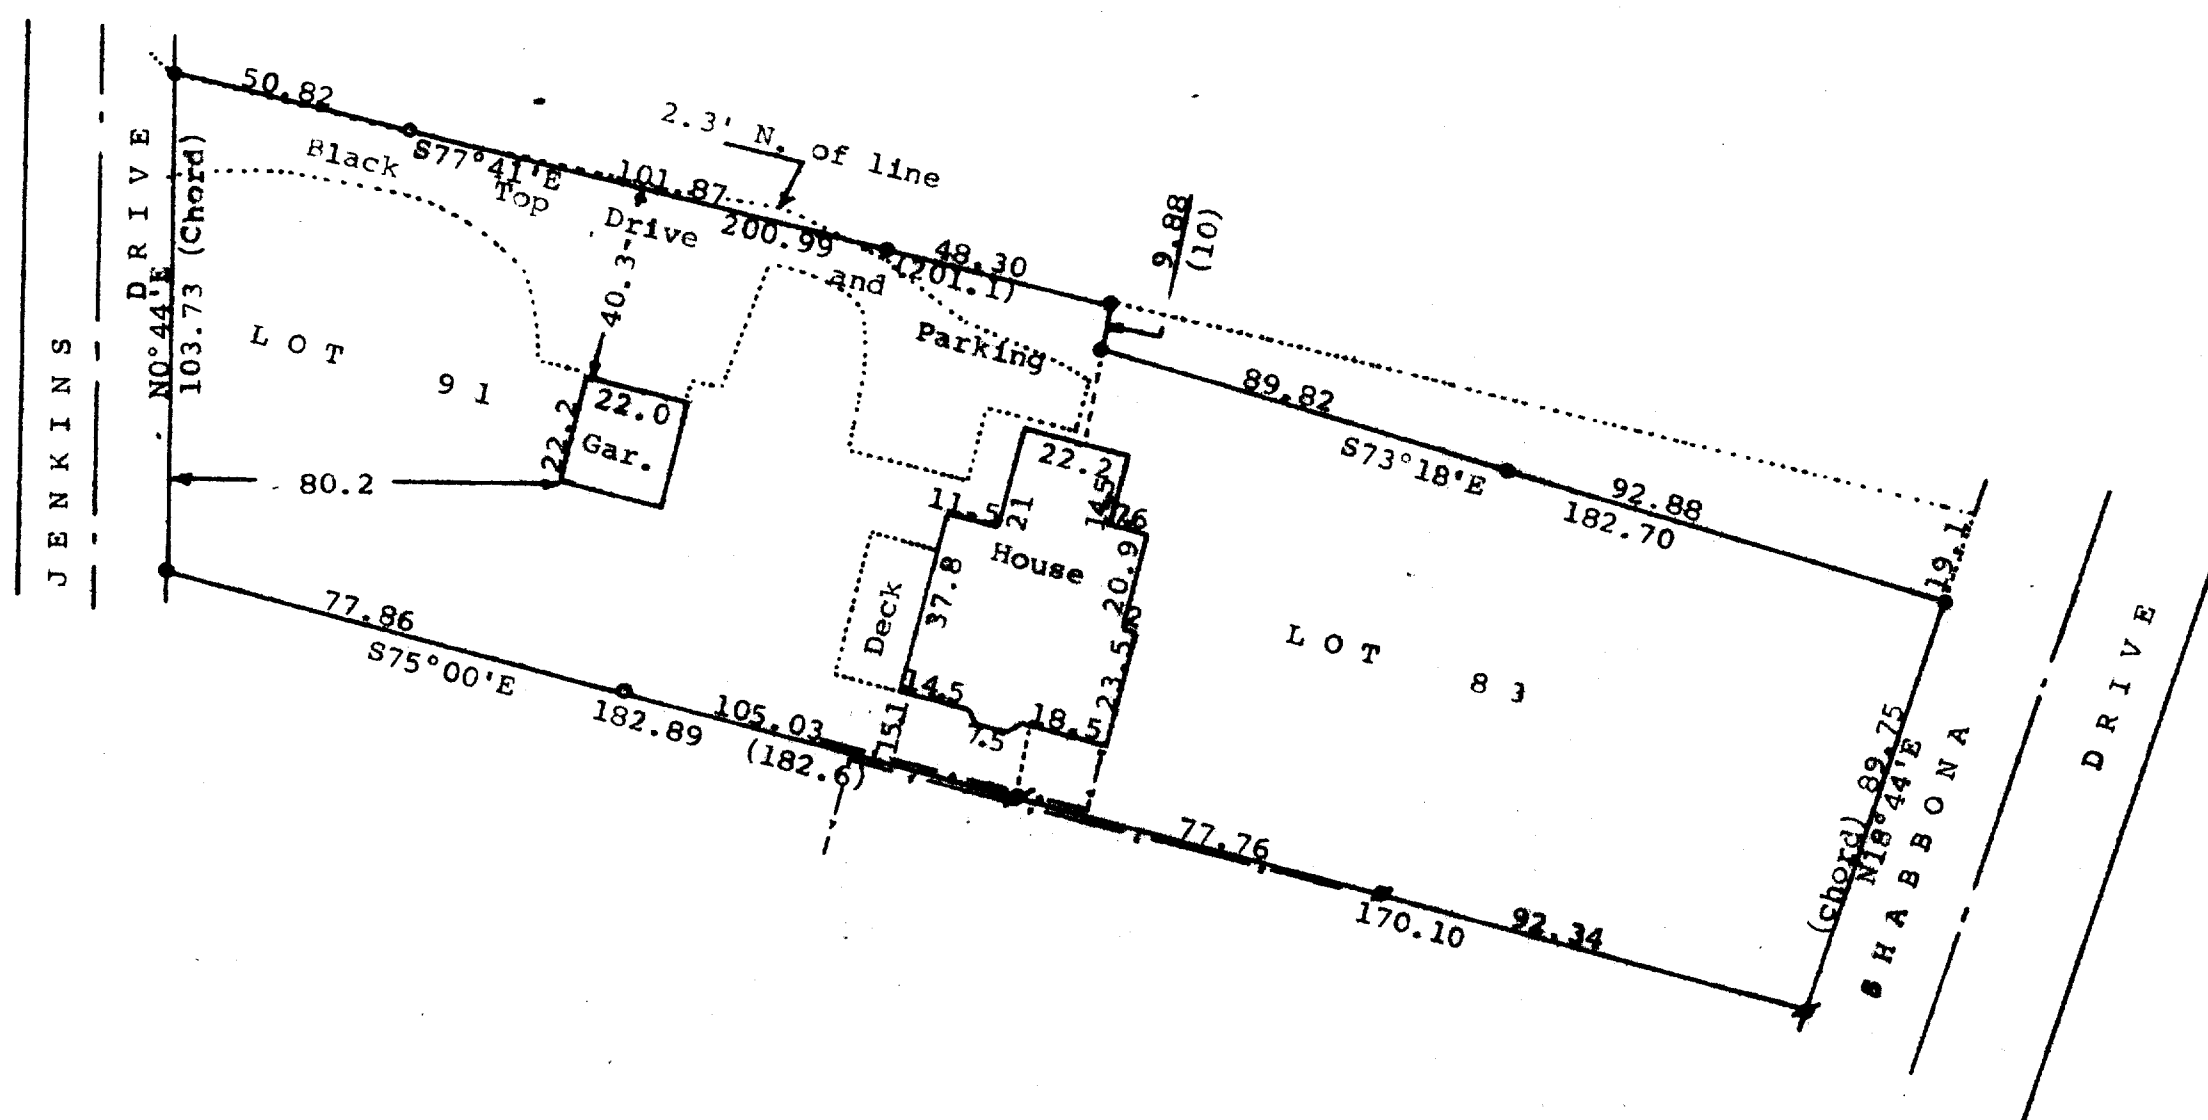

Scale - 1" = 40'

- = Concrete Monument Found
- = 3/4" Iron Pipe Found
- = 1" X 24" Iron Pipe Set
- +—+—+— = Fence Line

(0.00) = recorded distance

Bearings referenced to the south line of Lot 91 with the assumed bearing of S75°00'E

Owner: Helen Opitz
Fontana, WI 53125

George T. Dunham
George T. Dunham, Surveyor

