




FARRIS, HANSEN & ASSOCIATES, INC.
7 RIDGEWAY COURT, ELKHORN, WI
414-723-2098

N

PLAT OF SURVEY OF

UNIT 1 OF TIMBER RIDGE CONDOMINIUMS
LOCATED IN SW 1/4 SEC. 13, T. 1N., R. 16E.
VILLAGE OF FONTANA-ON-GENEVA LAKE
WALWORTH COUNTY, WISCONSIN

ORDERED BY:
VISNER BUILDERS

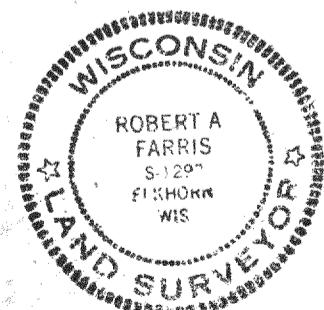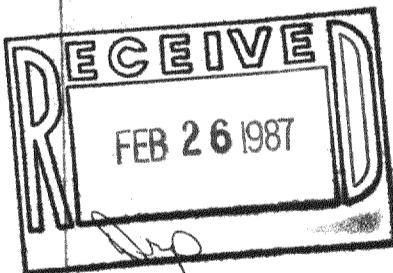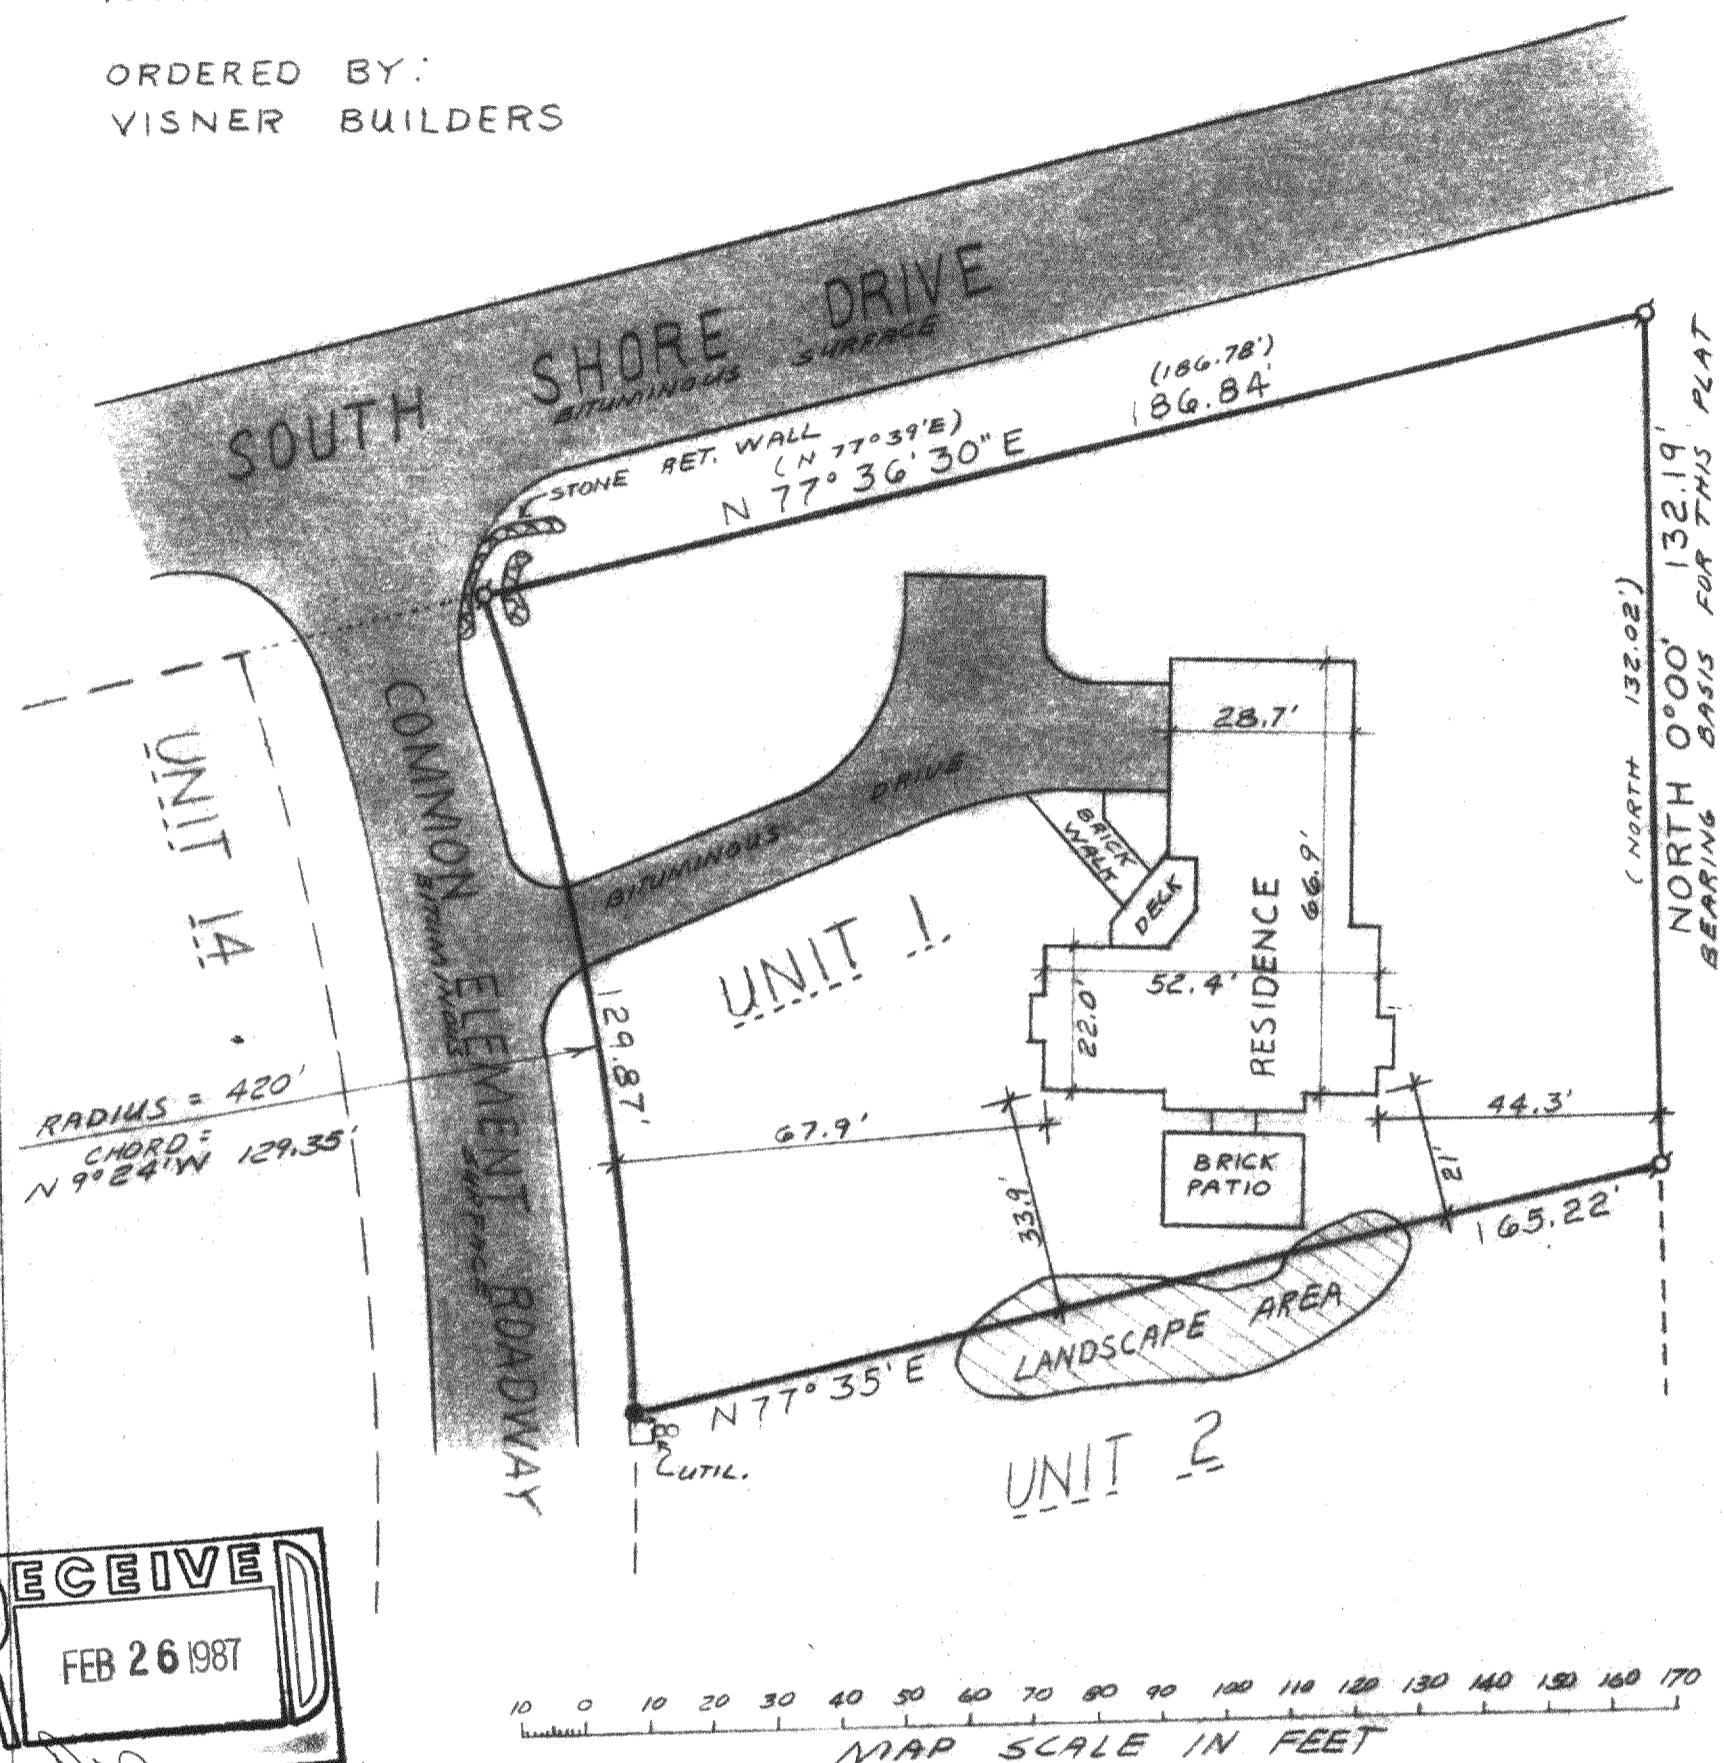

- = FOUND IRON PIPE SURVEY STAKE
- = SET RE-BAR STAKE
- (XXXX) = RECORD DIMENSION

I hereby certify that I have surveyed the above described property and that the above map is a true representation thereof and shows the size and location of the property, its exterior boundaries, the location of all visible structures and dimensions of all principal buildings thereon, boundary fences, apparent easements, roadways and visible encroachments, if any. This survey is made for the use of the present owners of the property, and also those who purchase, mortgage, or guarantee the title thereto within one (1) year from the date hereof.

Robert A. Farris

DATED 12/10/86

PROJECT #2210-1