


WALWORTH COUNTY
SURVEYING & MAPPING
LAKE GENEVA, WISCONSIN

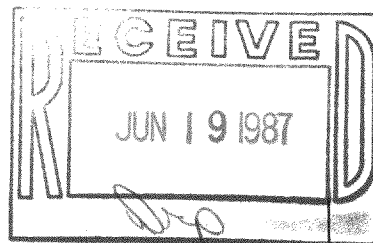

LOT 3

(N89°52'E 112.00')
112.15'

BRICKLEY DRIVE

(N0°08'W 90.00')
89.99'

GRAVEL DRIVEWAY

25.4'

HOUSE

DECK

LOT 4

90.14'
(N0°08'W 90.00')


111.90'
(N89°52'E 112.00')

LOT 5

PLAT OF SURVEY OF

LOT 4 OF BRICKLEY SUBDIVISION, LOCATED
IN THE VILLAGE OF FONTANA-ON-GENEVA
LAKE, WALWORTH COUNTY, WISCONSIN.

ORDERED BY: RICHARD CAIN
P. O. BOX 351
FONTANA, WISCONSIN

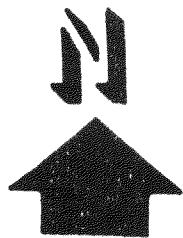

SCALE: 1"=20'

⊘ - IRON PIPE FOUND
○ - IRON ROD PLACED
() - RECORDED AS

I, ROBERT M. BAERENWALD, DO HEREBY CERTIFY THAT I
HAVE SURVEYED THE PROPERTY HEREON DESCRIBED ACCORDING
TO THE OFFICIAL RECORDS AND THAT THE PLAT HEREON IS A
CORRECT REPRESENTATION OF THE PROPERTY LINES TO THE
BEST OF MY KNOWLEDGE AND BELIEF.

Robert M. Baerenwald
ROBERT M. BAERENWALD
WISCONSIN REGISTERED LAND SURVEYOR, S-1508

April 24, 1987
DATE JOB NO. 1016

NOTE: THIS IS NOT A CERTIFIED COPY UNLESS SEALED.