


5-730-8

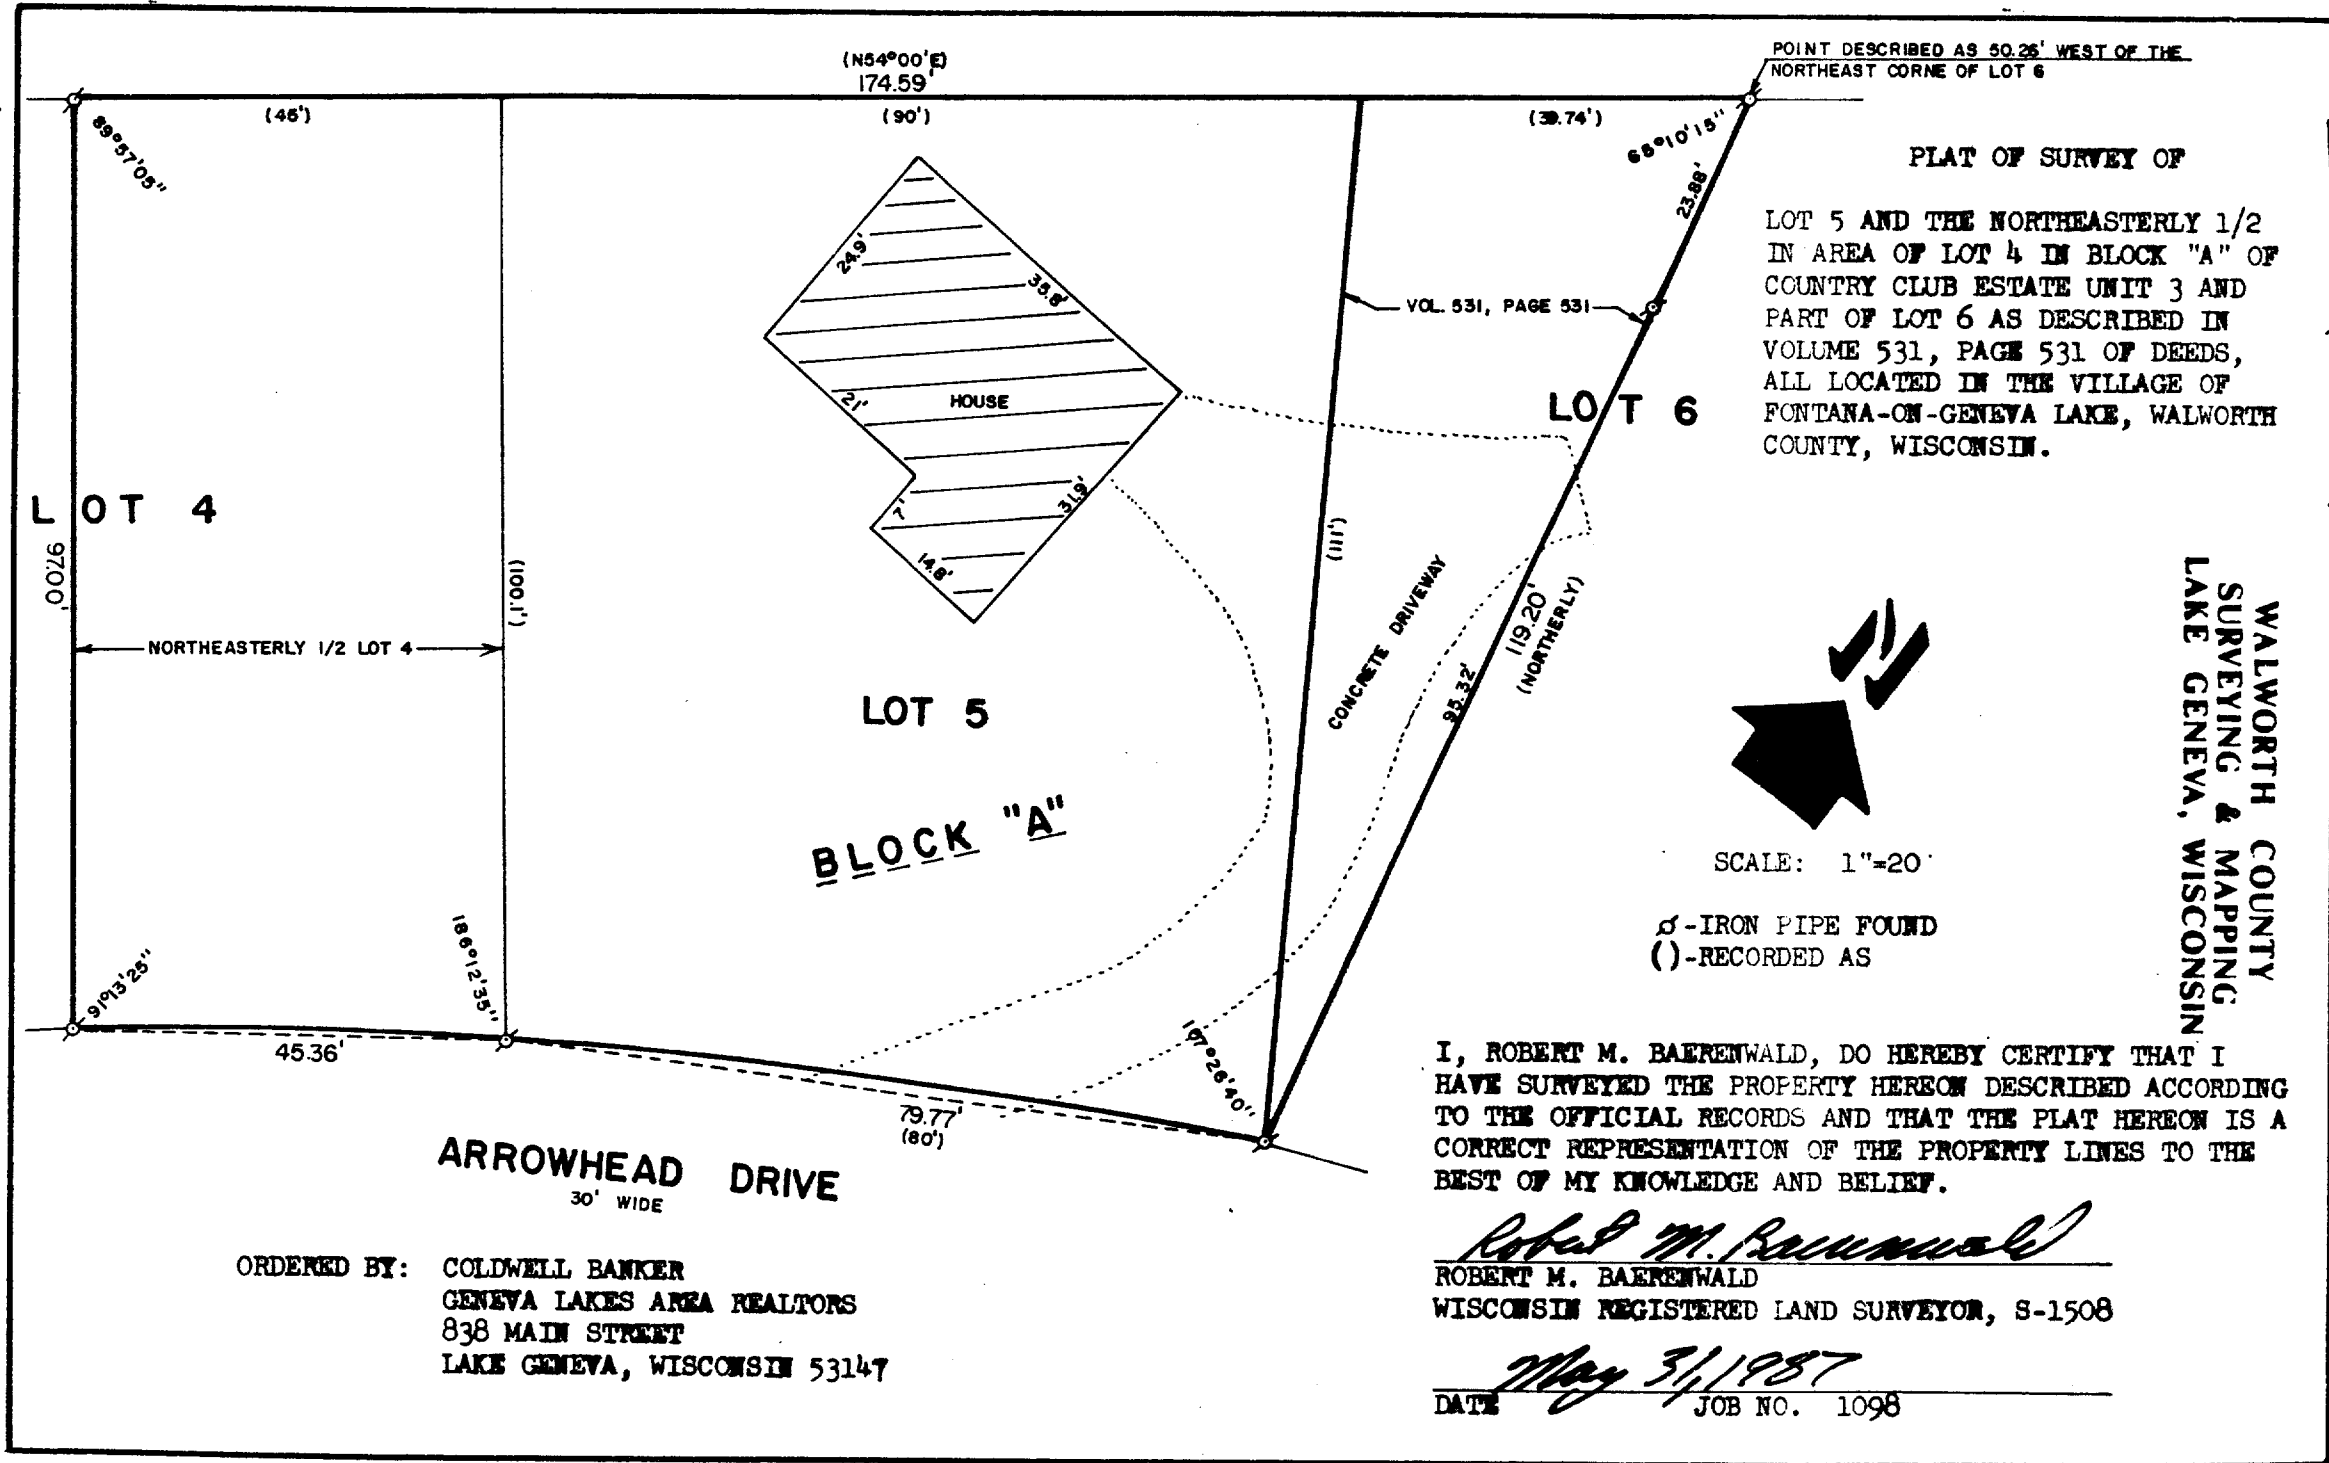

5-730