

FARRIS, HANSEN & ASSOCIATES, INC.

7 RIDGEWAY COURT, P.O. BOX 487, ELKHORN, WISCONSIN

TEL. 414-723-2098


LOCATION: UNIT 8 OF ABBEY SPRINGS CONDOMINIUM NO. 1  
VILLAGE OF FONTANA - ON - GENEVA LAKE  
WALWORTH COUNTY, WISCONSIN

WORK ORDERED BY: ATTY. BOB SMITH  
HILLSIDE, ILLINOIS

MAP LEGEND

- = IRON PIPE STAKE FOUND
- ⊗ = PK NAIL STAKE SET IN PAV'T.
- = IRON ROD STAKE FOUND
- = IRON ROD STAKE SET
- = CONCRETE MONUMENT FOUND
- (XXXXX) = RECORD DIMENSION

MAP SCALE IN FEET

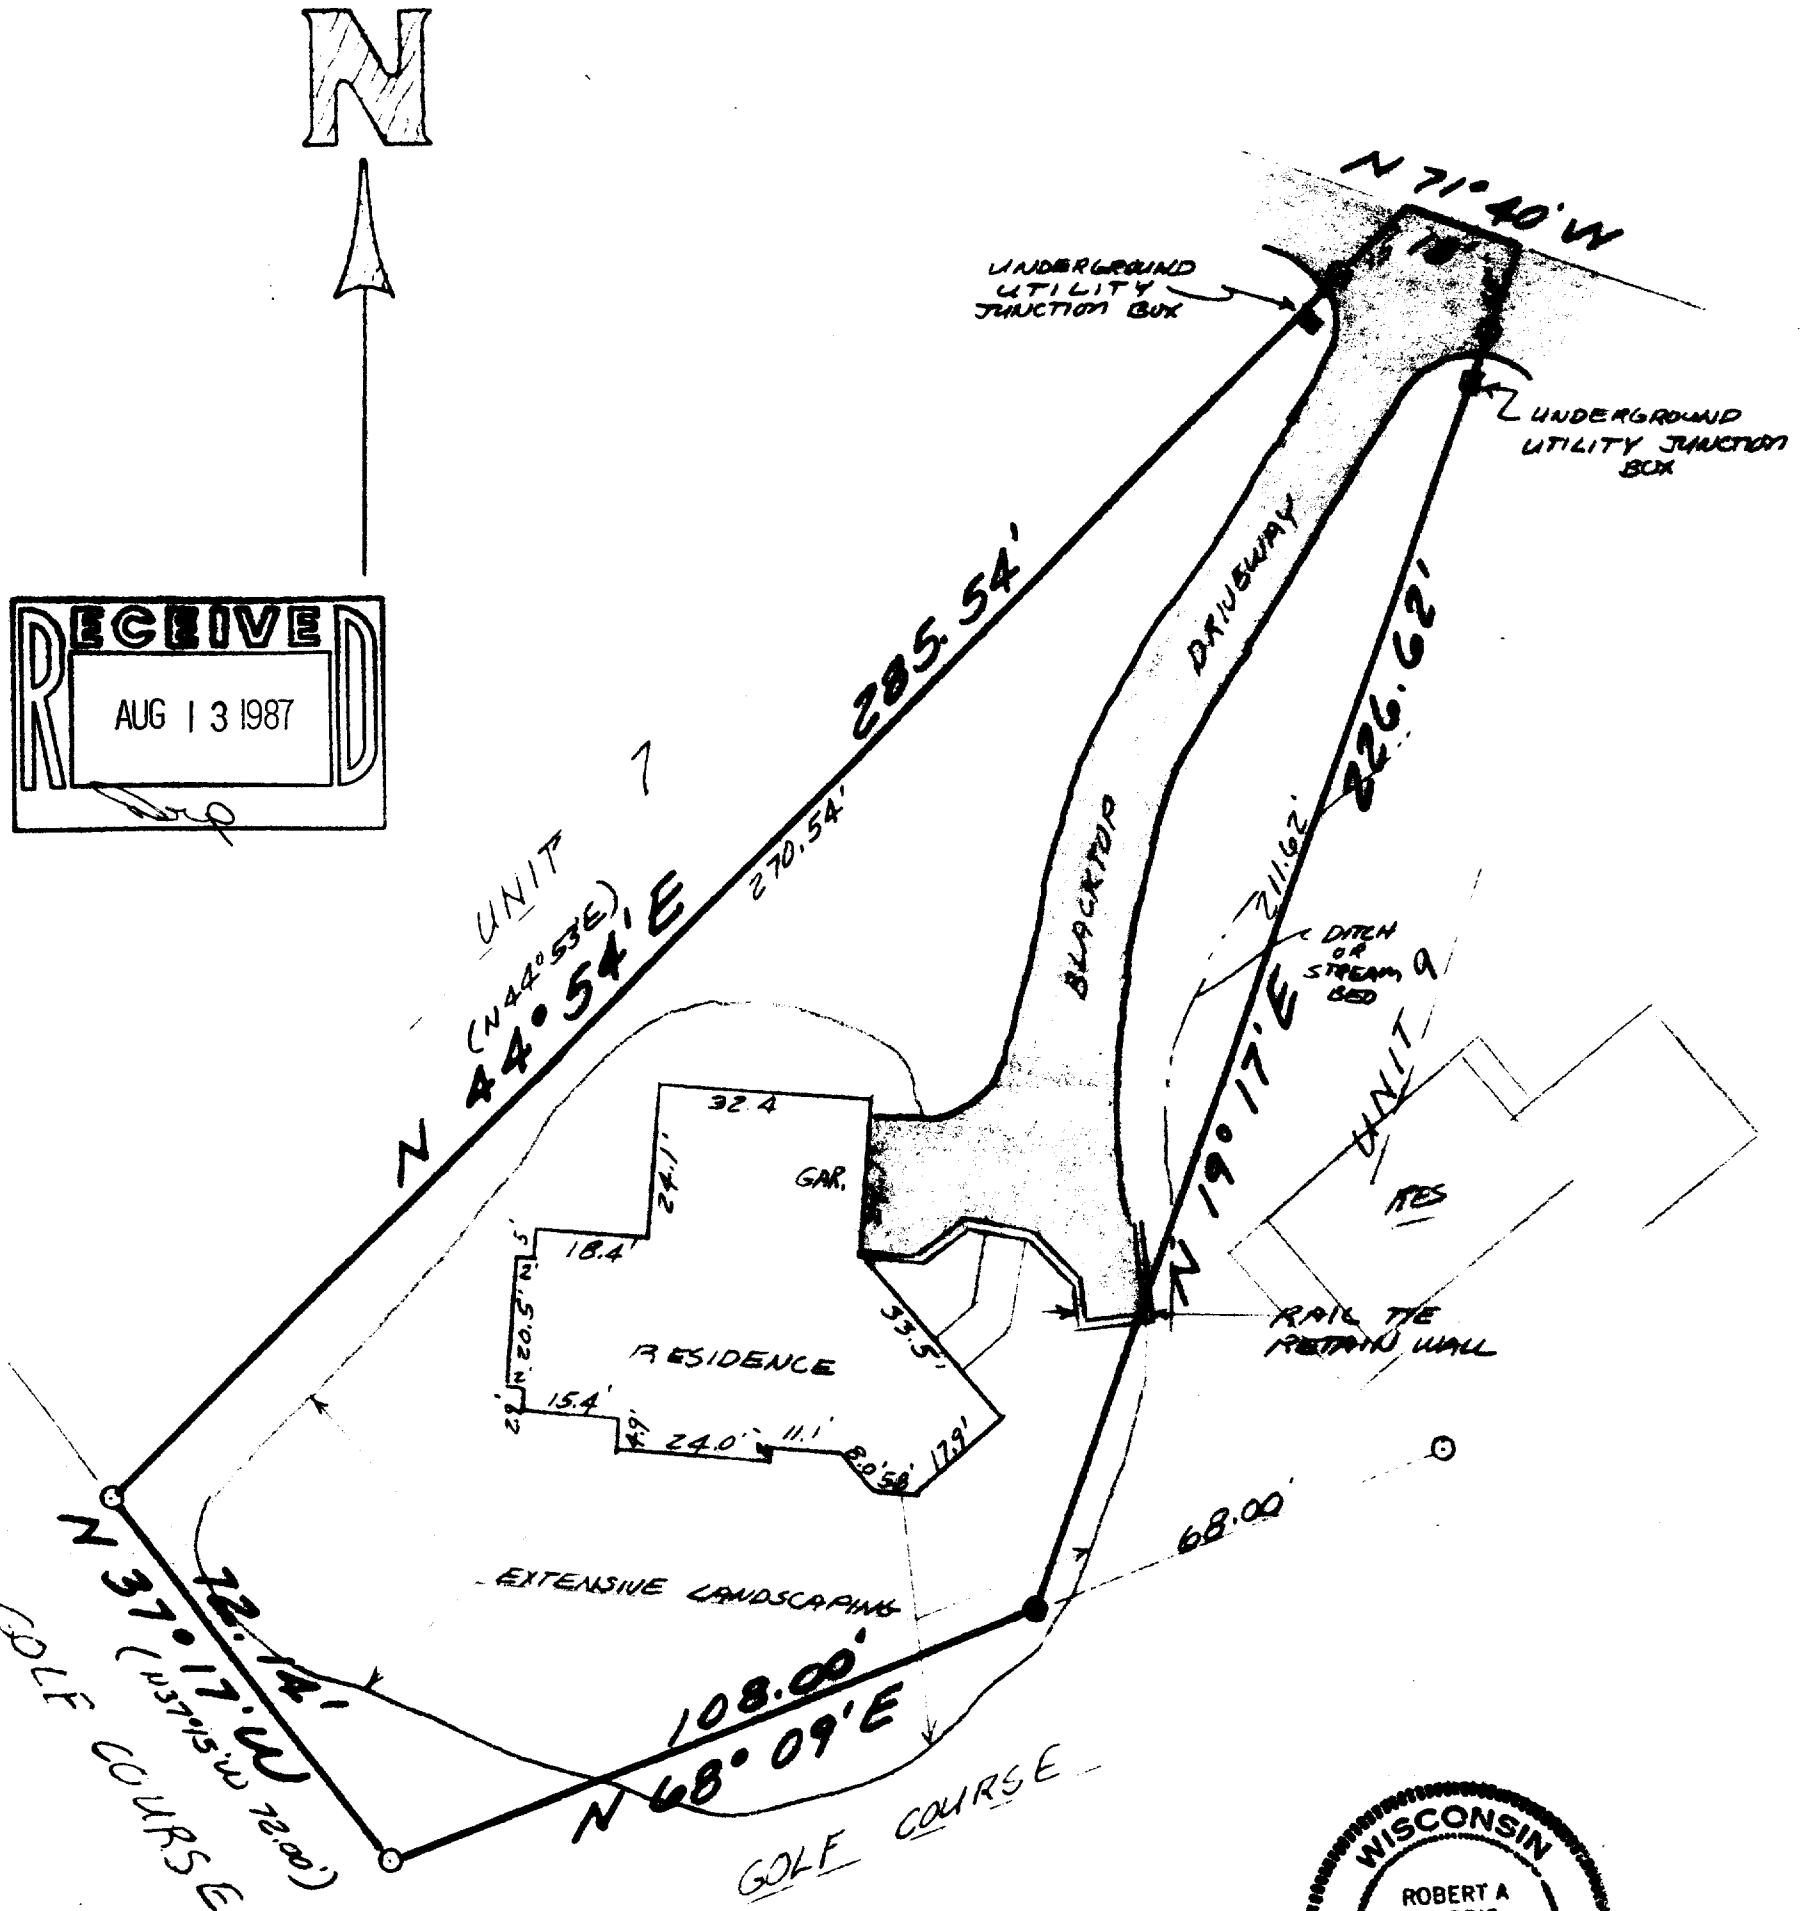

I hereby certify that the above described property has been surveyed under my direction and that the above map is a true representation thereof and shows the size and location of the property, its exterior boundaries, the location of all visible structures and dimensions of all principal buildings thereon, boundary fences, apparent easements, roadways and visible encroachments, if any. This survey is made for the use of the present owners of the property, and also those who purchase, mortgage, or guarantee the title thereto within one year from the date hereof.

DATED : JULY 31, 1987

*Robert A. Farris*

PROJ. NO. 2841