



**ABELL  
SURVEYING & MAPPING  
DELANAN, WISCONSIN 53115  
414-728-6737**

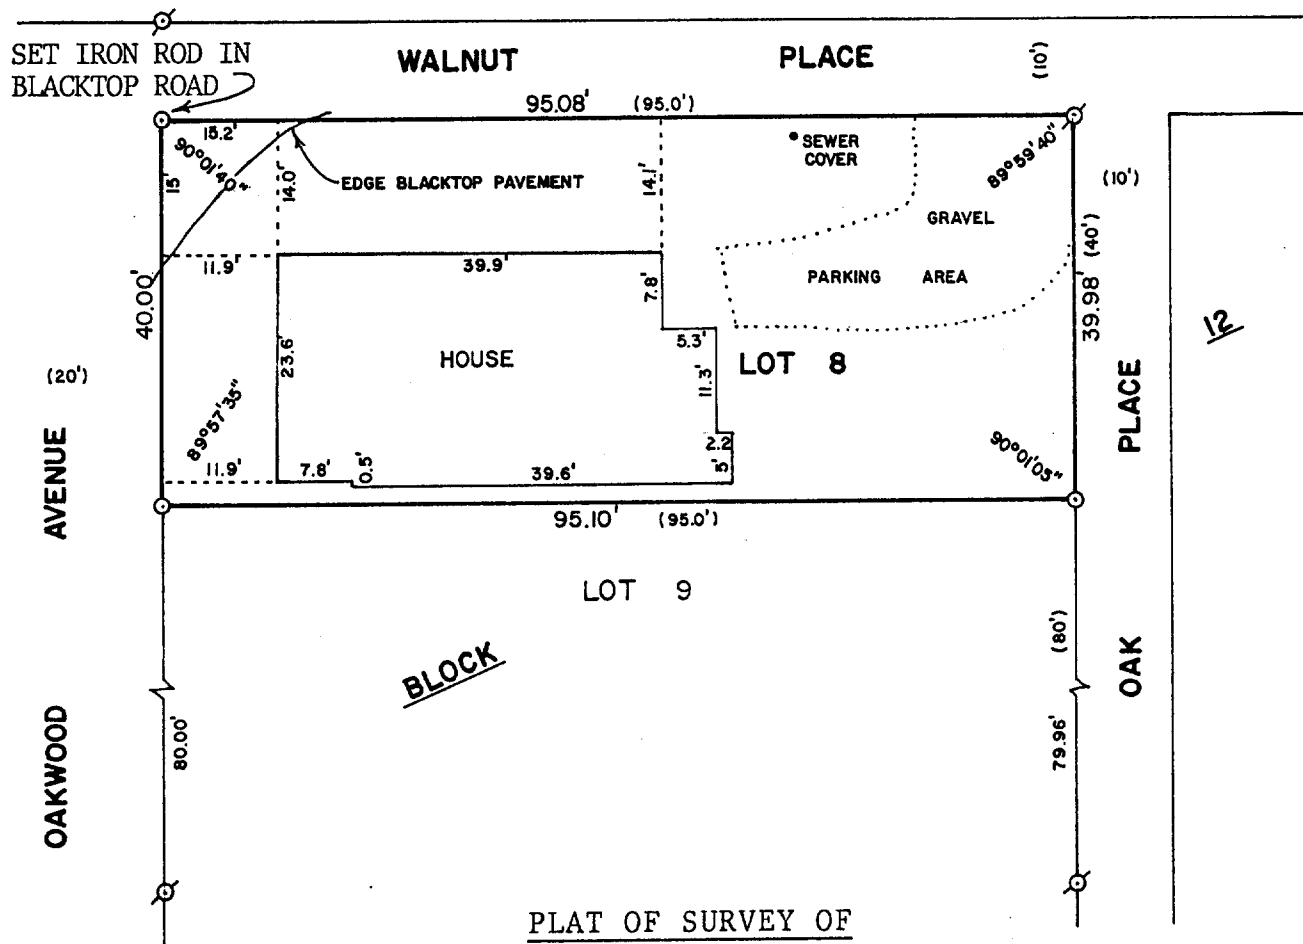

PLAT OF SURVEY OF

LOT 8, BLOCK 12 OF GLENWOOD SPRINGS, A SUBDIVISION  
 LOCATED IN THE VILLAGE OF FONTANA-ON-GENEVA,  
 WALWORTH COUNTY, WISCONSIN.

ORDERED BY: DEBBIE SCHROEDER  
 KEEFE REAL ESTATE  
 P.O. BOX 268  
 WALWORTH, WI. 53184

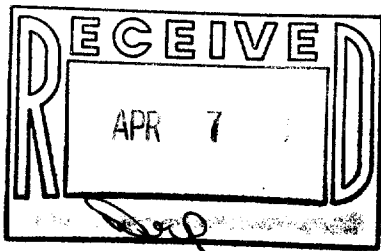

SCALE - 1"=20'

**LEGEND**

- ⊗ - IRON PIPE FOUND
- - IRON ROD SET
- ( ) - RECORDED AS

I, DAVID F. ABELL, DO HEREBY CERTIFY  
 THAT I HAVE SURVEYED THE PROPERTY  
 HEREON DESCRIBED ACCORDING TO THE  
 OFFICIAL RECORDS AND THAT THE PLAT  
 HEREON IS A CORRECT REPRESENTATION  
 OF THE PROPERTY LINES TO THE BEST OF  
 MY KNOWLEDGE AND BELIEF.

*David F. Abell*  
 DAVID F. ABELL  
 WISCONSIN REGISTERED LAND SURVEYOR, S-1596

*March 22, 1988*  
 DATE JOB NUMBER - 88041

NOTE: THIS IS NOT A CERTIFIED COPY UNLESS SEALED. 5-815