



ABELL  
SURVEYING & MAPPING  
DELAVER, WISCONSIN 53115  
414-728-6737

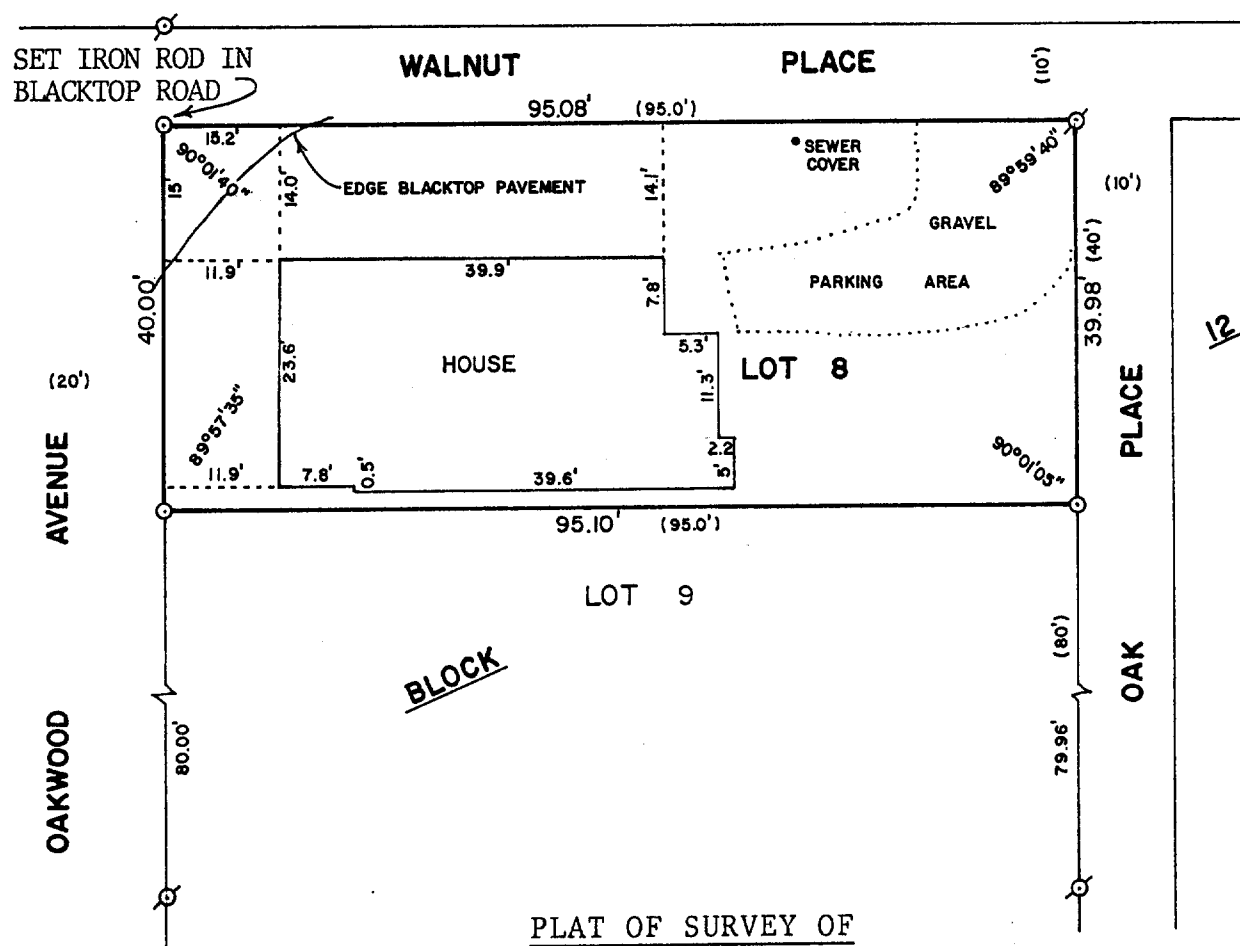

LOT 8, BLOCK 12 OF GLENWOOD SPRINGS, A SUBDIVISION  
LOCATED IN THE VILLAGE OF FONTANA-ON-GENEVA,  
WALWORTH COUNTY, WISCONSIN.

ORDERED BY: DEBBIE SCHROEDER  
KEEFE REAL ESTATE  
P.O. BOX 268  
WALWORTH, WI. 53184

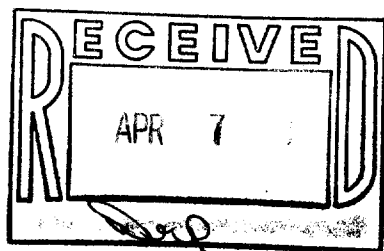

SCALE - 1"=20'

LEGEND

- ⊗ - IRON PIPE FOUND
- - IRON ROD SET
- ( ) - RECORDED AS

I, DAVID F. ABELL, DO HEREBY CERTIFY  
THAT I HAVE SURVEYED THE PROPERTY  
HEREON DESCRIBED ACCORDING TO THE  
OFFICIAL RECORDS AND THAT THE PLAT  
HEREON IS A CORRECT REPRESENTATION  
OF THE PROPERTY LINES TO THE BEST OF  
MY KNOWLEDGE AND BELIEF.

*David F. Abell*  
DAVID F. ABELL  
WISCONSIN REGISTERED LAND SURVEYOR, S-1596

*March 22, 1988*  
DATE JOB NUMBER - 88041

NOTE: THIS IS NOT A CERTIFIED COPY UNLESS SEALED. 5-815