


RECEIVED
MAY 9 1988

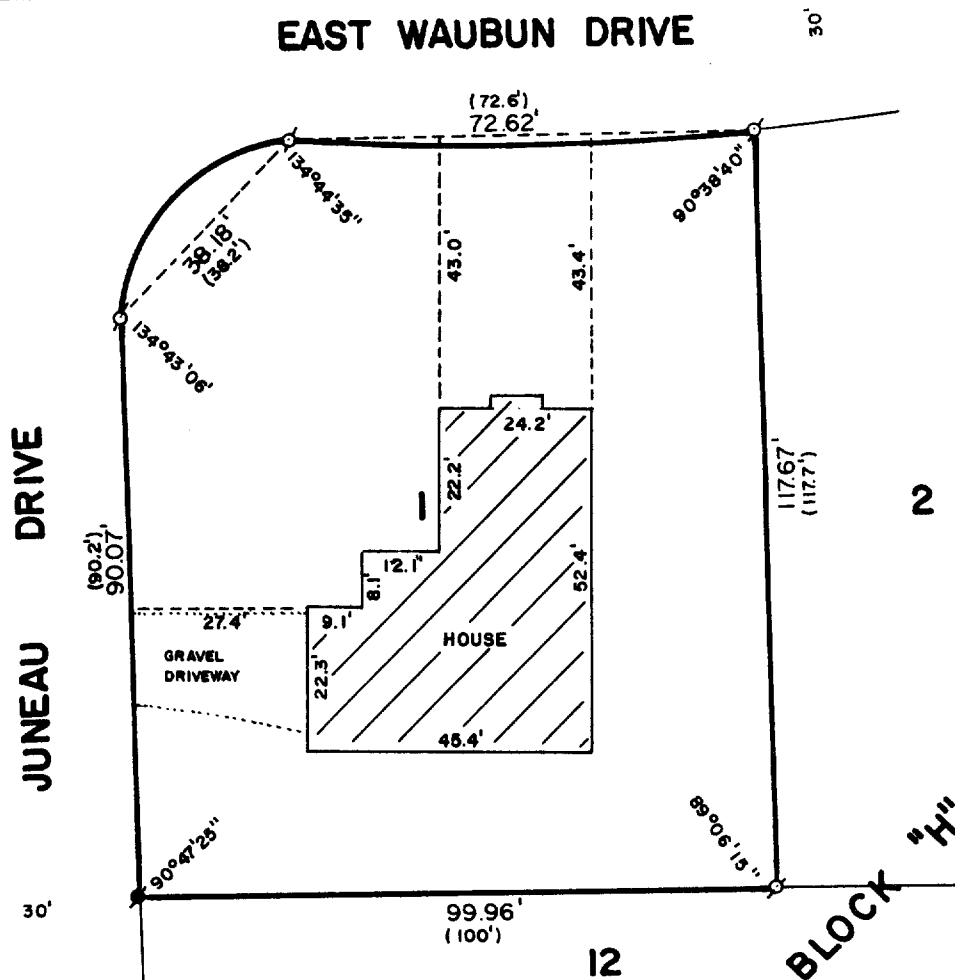

LOT 1, BLOCK "H" OF COUNTRY CLUB ESTATES
UNIT 3, LOCATED IN THE VILLAGE OF FONTANA-
ON-GENEVA LAKE, WALWORTH COUNTY, WISCONSIN.

♂ - IRON PIPE FOUND
 ♀ - CONCRETE MONUMENT FOUND
 () - RECORDED AS

Robert M. Baerenwald
ROBERT M. BAERENWALD
WISCONSIN REGISTERED LAND SURVEYOR, S-1508

DATE March 29, 1966 JOB NO. 1458

NOTE: THIS IS NOT A CERTIFIED COPY UNLESS SEALED.

5-972