

PLAT OF SURVEY OF LOT 5 BLOCK 8 OF
GLENWOOD SPRINGS SUB. IN 14-1-16

WALWORTH CO. WI.
FOR YISNER CONSTR.

LOT 4

(NORTH 40')
N 0°34'W 40.19'

Bearing Basis for THIS Plot
S 89°47' E 70.00'

FENCE COR. 0.4 N.
FENCE COR. 0.17 N.

Basement Entrance

CONC.

Hydrant

N 44°24' W 14.56'
N 41°35' W 25.5'
N 53°27' W 25.5'

OVERHEAD WIRE

EXISTING RESIDENCE

18" OAK

16" OAK

18" OAK



22" OAK

18" BOX ELDER OR MYRTLE AVE

BITUMINOUS

HAZEL CT.

RECEIVED
MAY 19 1988

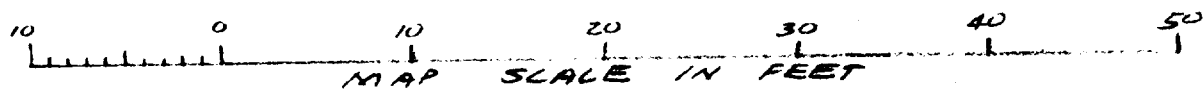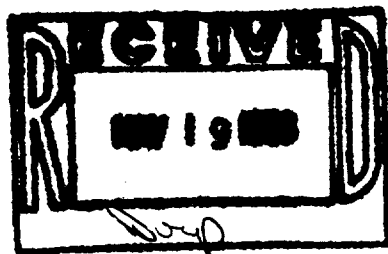

Ø = Iron Pipe Survey Stake Found
 O = Iron Rod Survey Stake Found
 (xxx) = Record Dimension
 ---x--- = FENCE

I hereby certify that the above described property has been surveyed under my direction and that the above map is a true representation thereof and shows the size and location of the property, its exterior boundaries, the location of all visible structures and dimensions of all principal buildings thereon, boundary fences, apparent easements, roadways and visible encroachments, if any. This survey is made for the use of the present owners of the property, and also for those who purchase, mortgage, or guarantee the title thereto within one (1) year from the date hereof.

PROJECT NO. 2994

5-827