
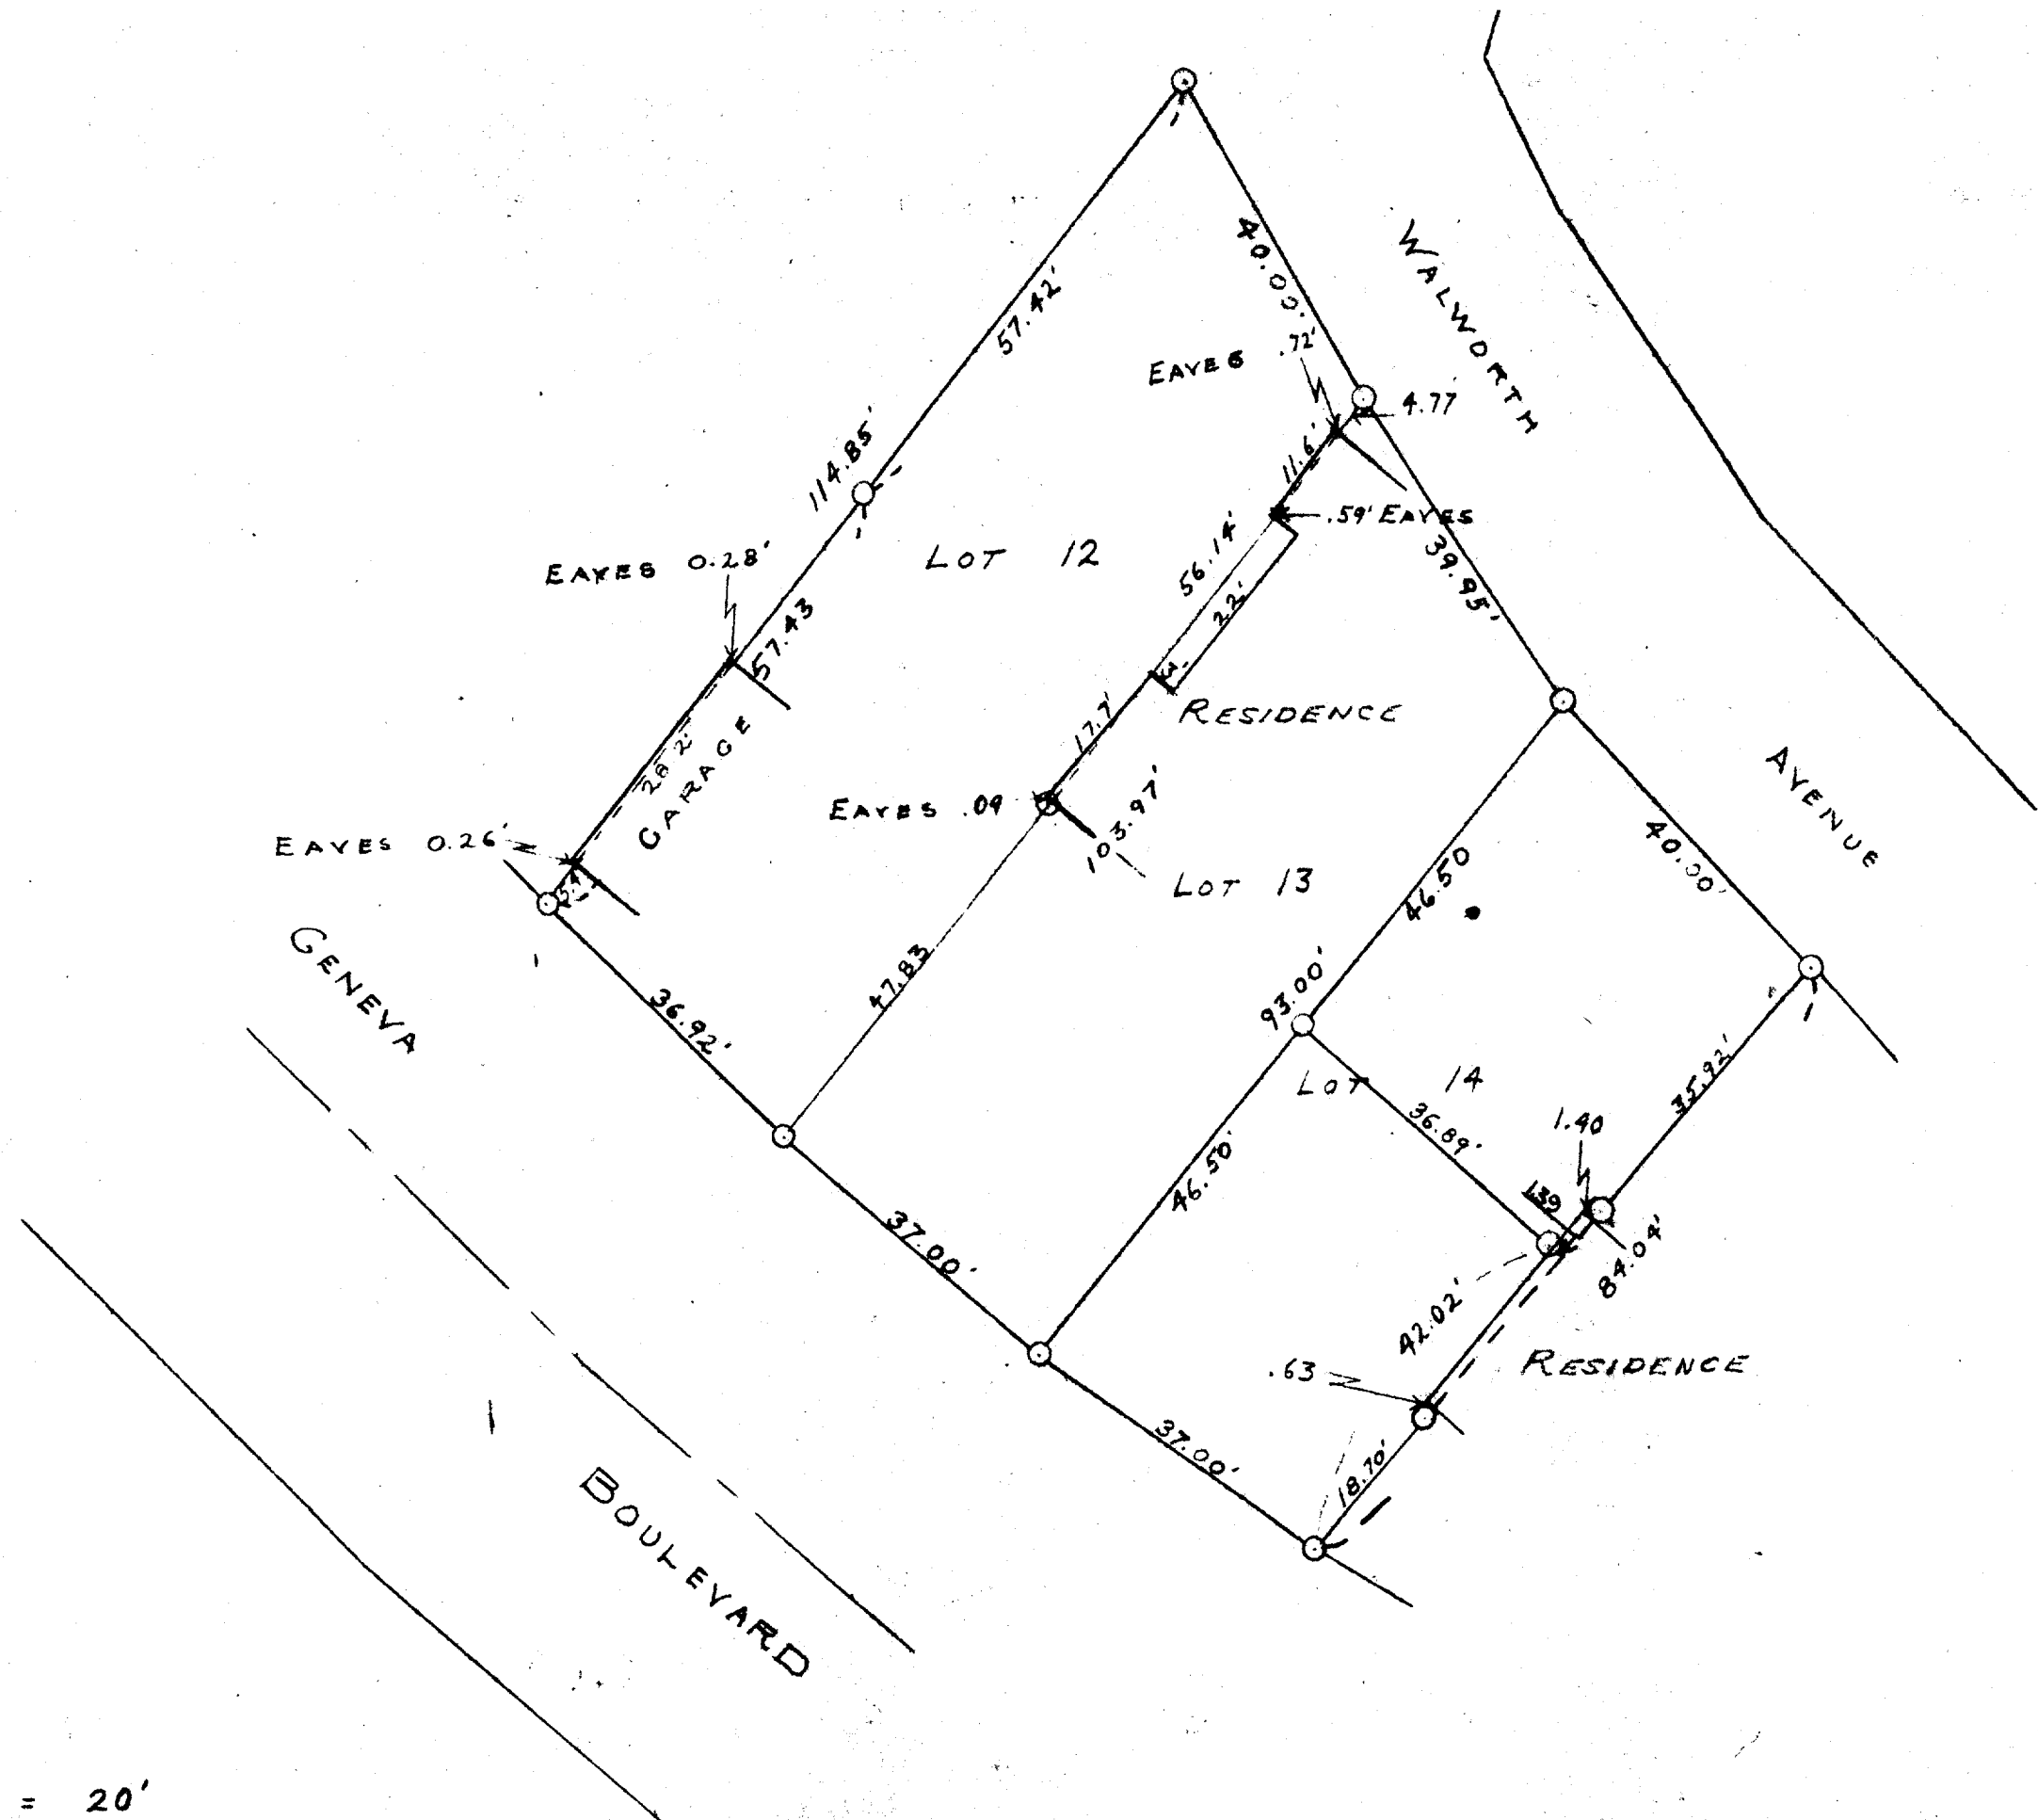


N

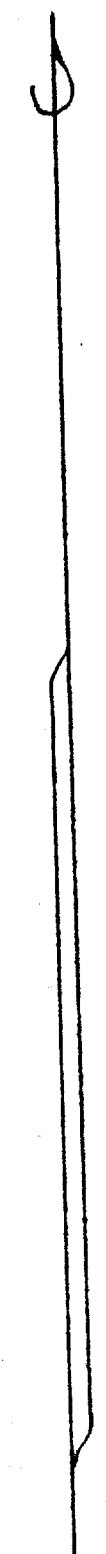

SCALE 1" = 20'
O = IRON STAKE

PLAT OF SURVEY OF LOTS 12 AND 14
BLOCK 7 GLENWOOD SPRINGS WALWORTH COUNTY
WISCONSIN
OCTOBER 26, 1951

Clayton L. Jensen
COUNTY SURVEYOR

5-82J