


ABELL  
SURVEYING & MAPPING  
DELAVER, WISCONSIN 53115  
414-728-6737

FOUND SPIKE IN TOP OF WALL OF  
ORNAMENTAL POOL AT LOT CORNER.  
WALL EXTENDS OVER LOT LINE TO  
THE WEST ±1.5 FEET.

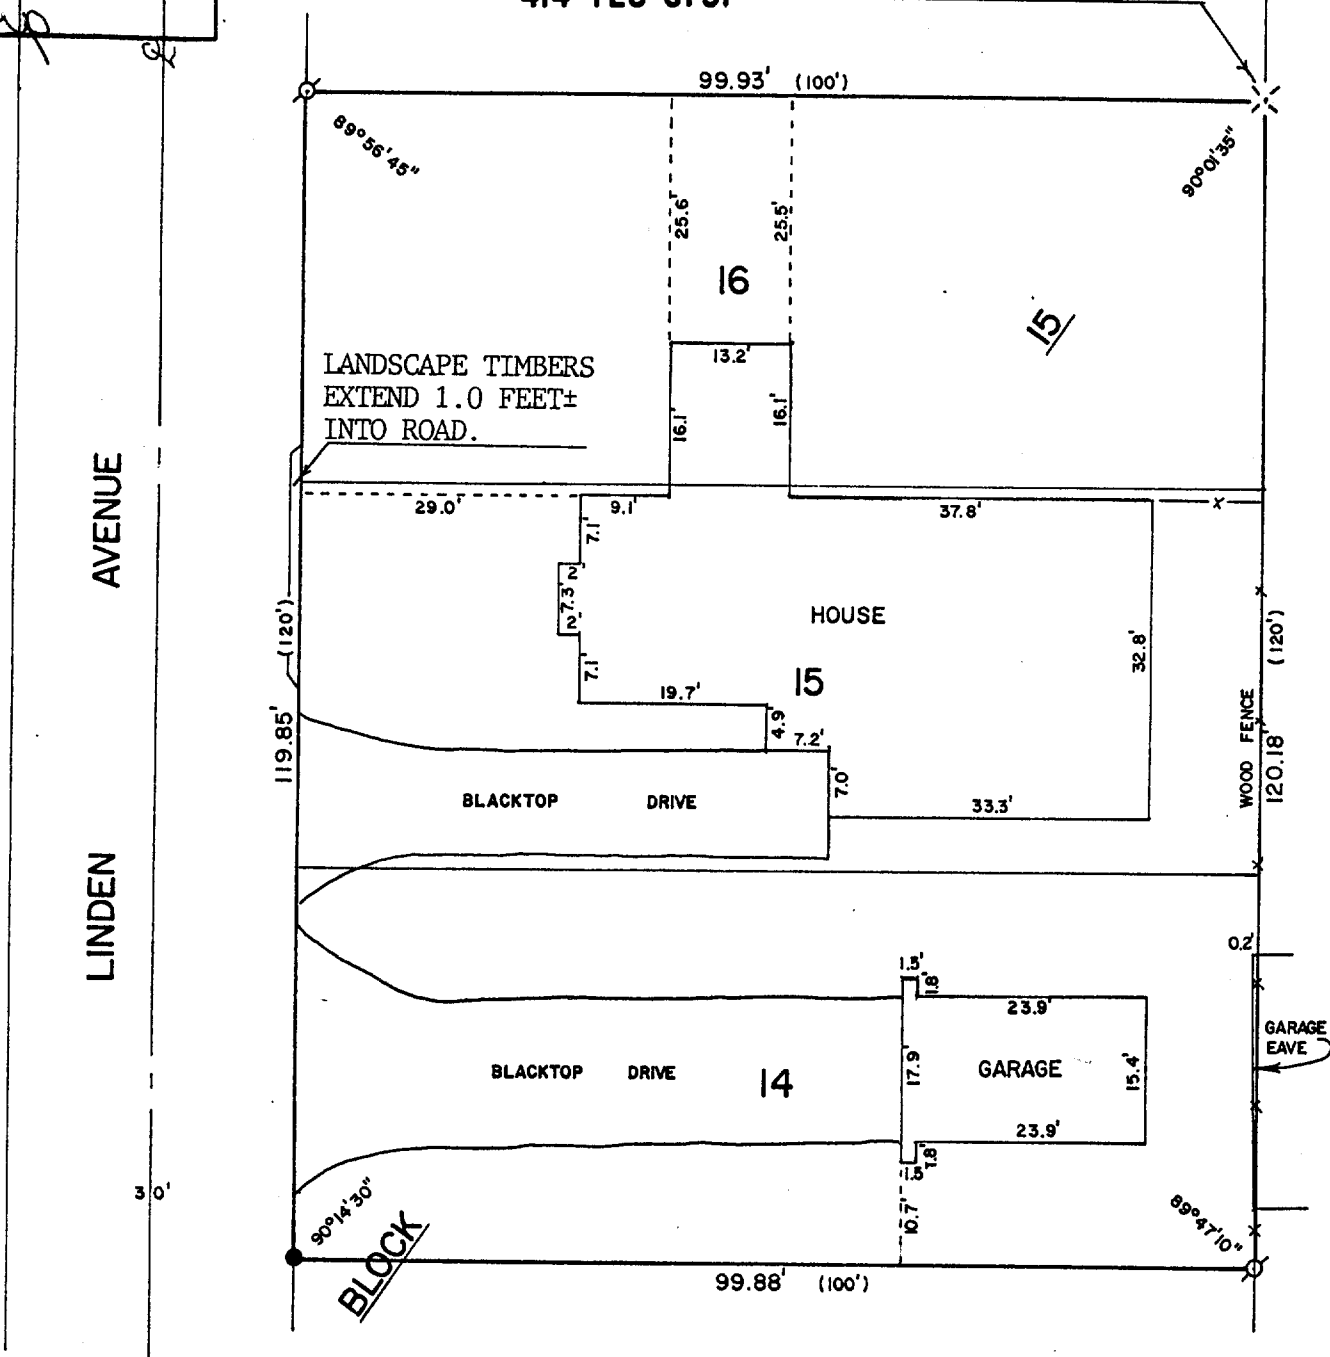

PLAT OF SURVEY OF

LOTS 14-16, BLOCK 15 OF GLENWOOD SPRINGS, LOCATED IN SECTION  
14, T1N, R16E, VILLAGE OF FONTANA-ON-GENEVA LAKE, WALWORTH  
COUNTY, WISCONSIN.

ORDERED BY: KEEFE REAL ESTATE  
P.O. BOX 268  
WALWORTH, WI. 53184



SCALE - 1"=20'

- LEGEND
- - IRON PIPE FOUND
  - - IRON ROD FOUND
  - ✕ - SPIKE FOUND
  - ( ) - RECORDED AS

I, DAVID F. ABELL, DO HEREBY CERTIFY  
THAT I HAVE SURVEYED THE PROPERTY  
HEREON DESCRIBED ACCORDING TO THE  
OFFICIAL RECORDS AND THAT THE PLAT  
HEREON IS A CORRECT REPRESENTATION  
OF THE PROPERTY LINES TO THE BEST OF  
MY KNOWLEDGE AND BELIEF.

*David F. Abell*

DAVID F. ABELL  
WISCONSIN REGISTERED LAND SURVEYOR, S-1596

DATE *June 7, 1988*

JOB NUMBER - 88099

NOTE: THIS IS NOT A CERTIFIED COPY UNLESS SEALED.