


E. LINE BLOCK 16  
ASSIGNED BEARING NORTH




BEARING BASIS THIS PLAT

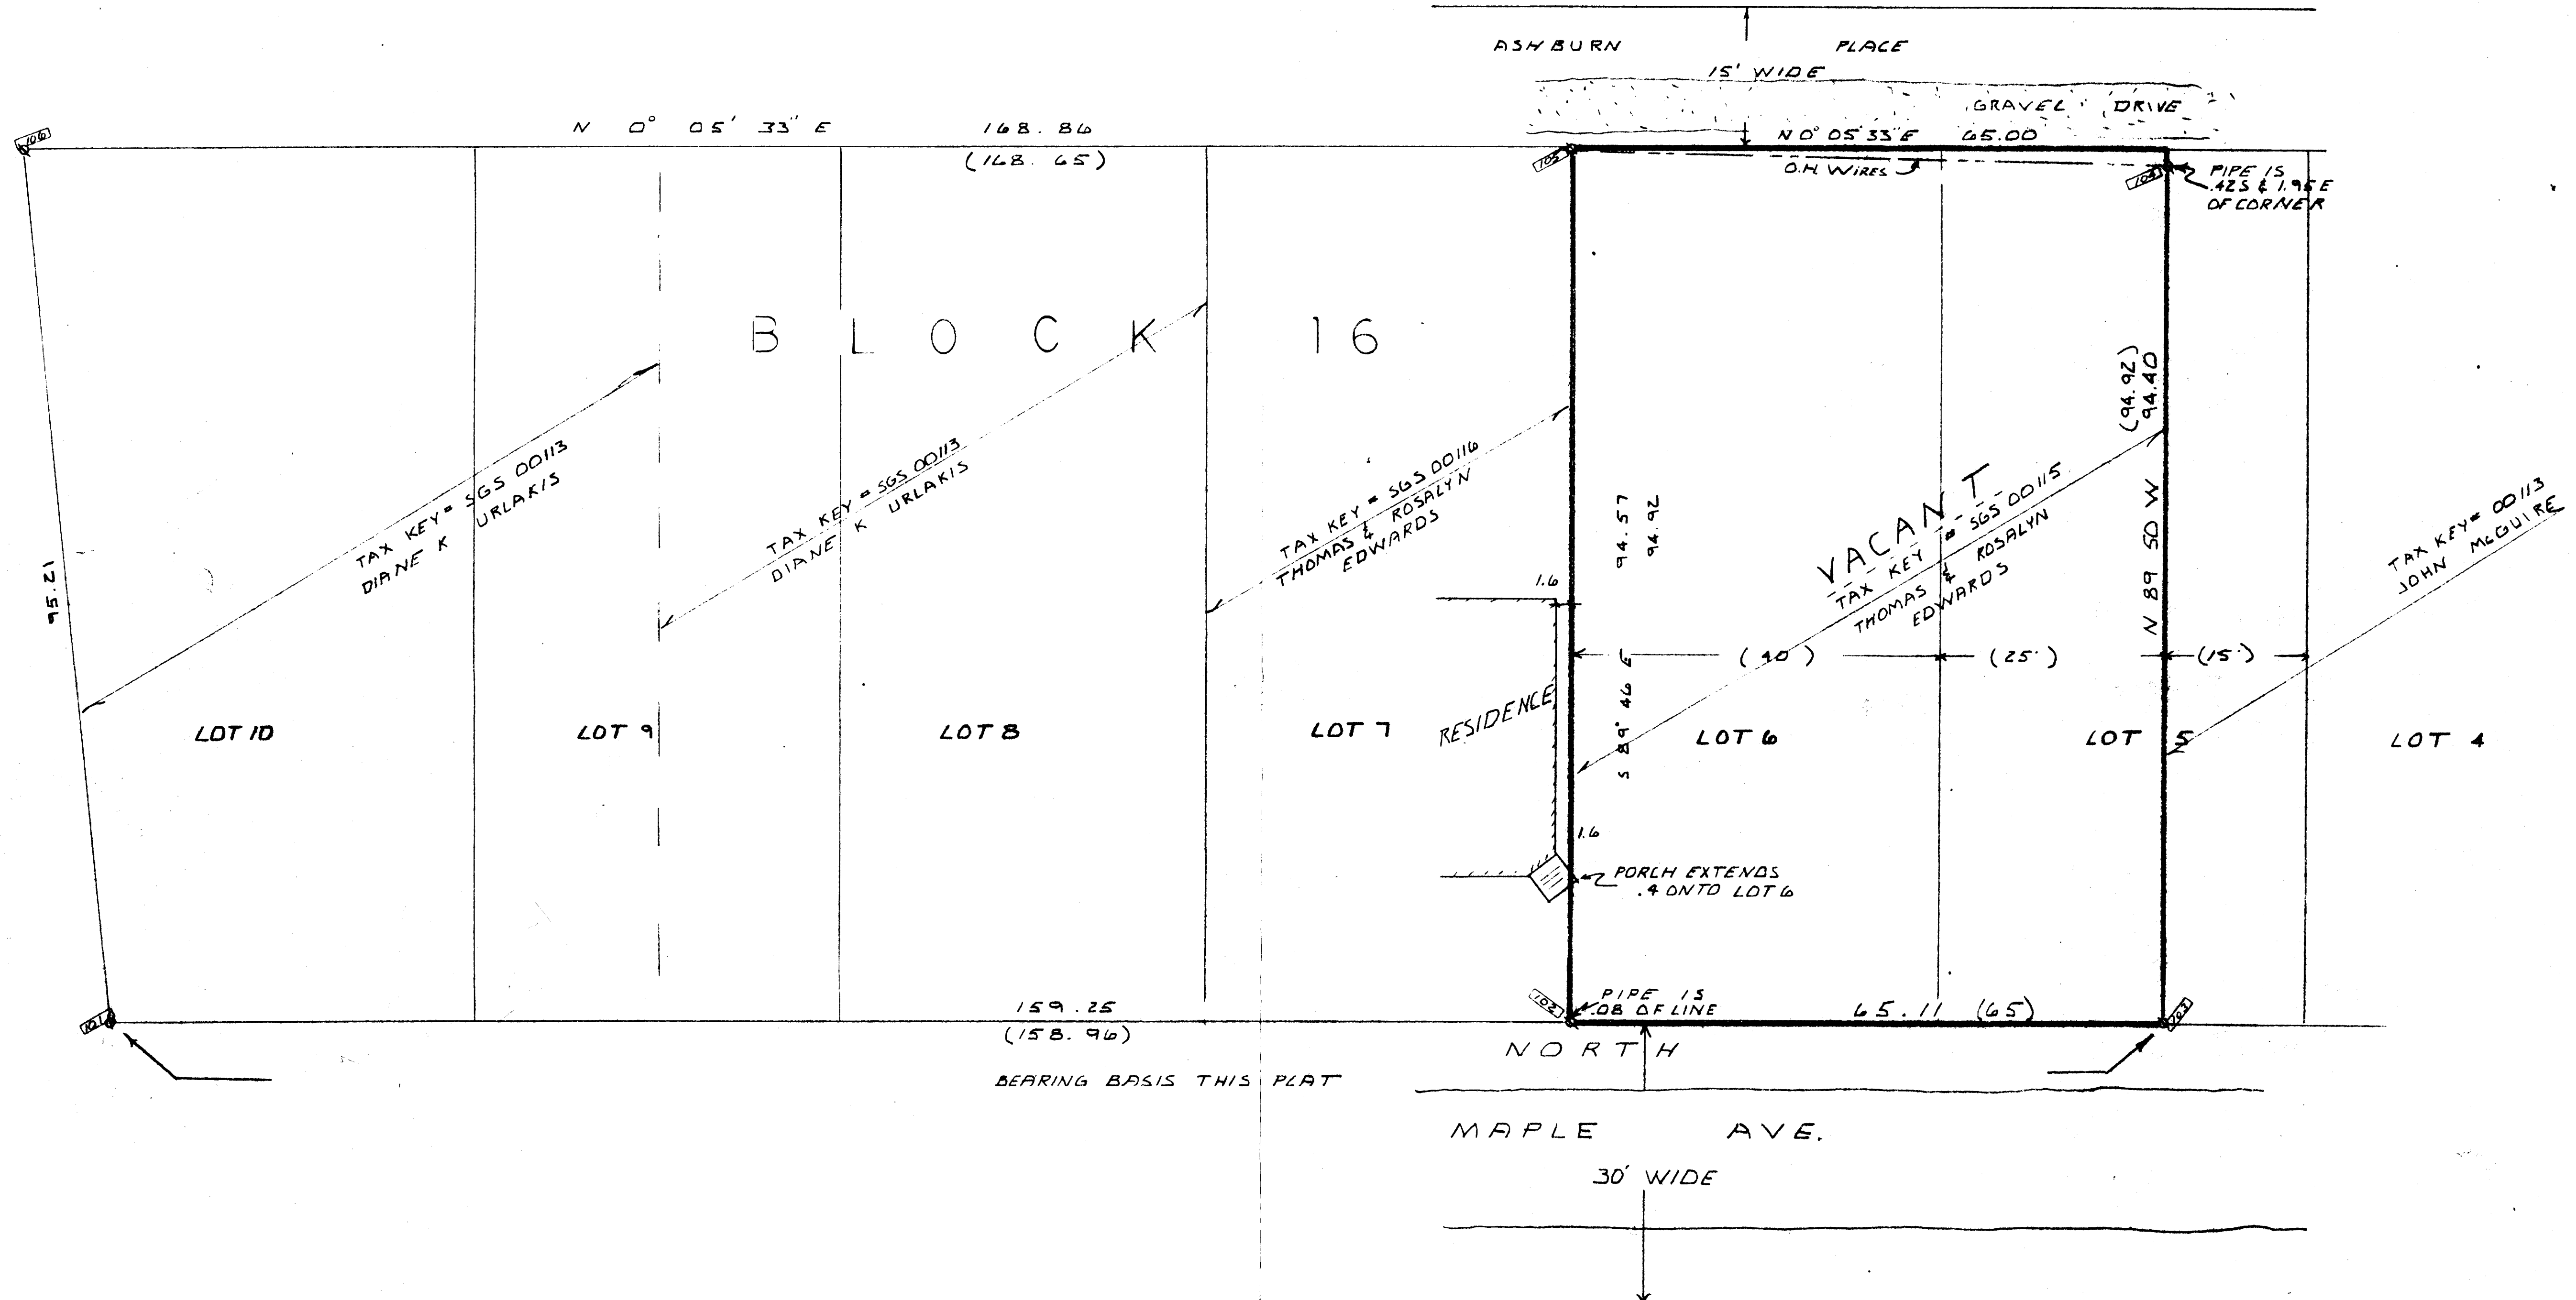

MAP SCALE IN FEET  
 Ø = IRON PIPE SURVEY STAKE FOUND  
 (YY) = RECORD DIMENSION FROM DEEDS OR MAPS OF RECORD  
 XX = MEASURED DIMENSION  
 [XXY] = COMPUTER COORDINATE FILE POINT LABEL

PLAT OF SURVEY OF LOT 6 AND THE SOUTH 25 FEET OF LOT 5 OF  
 BLOCK 16 OF GLENWOOD SPRINGS IN VILLAGE OF FONTANA, WAL. CO., WI.  
 FOR  
 THOMAS G. EDWARDS

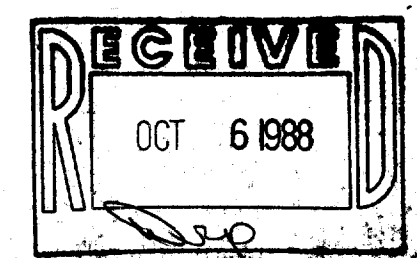

Farris, Hansen & Associates, Inc.


7 RIDGEMAY COURT, P.O. BOX 487, ELKHORN, WISCONSIN TEL. 414-723-2898

NOTE: COPIES OF THIS MAP TO WHICH THE FOLLOWING CERTIFICATE WILL APPLY ARE BLUE LINE PRINTS SHOWING SURVEYOR'S SEAL AND SIGNATURE IN BLACK INK. COPIES BY ANY OTHER MEANS MAY HAVE ALTERATIONS WHICH DO NOT REPRESENT THE SURVEYOR'S WORK PRODUCT.

I hereby certify that the above described property has been surveyed under my direction and that the above map is a true representation thereof and shows the size and location of the property, its exterior boundaries, the location of all visible structures and dimensions of all principal buildings thereon, boundary fences, apparent easements, roadways and visible encroachments, if any. This survey is made for the use of the present owners of the property, and also those who purchase, mortgage, or guarantee the title thereto within one year from the date hereof.

DATED: JUNE 23, 1988

PROJ. NO. 3042

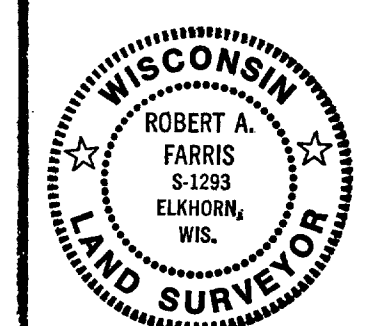

3042