

PLAT OF SURVEY of


Lot 2, Block 8 of Glenwood Springs Subdivision "W-Part"
located in Section 14, T 1 N, R 16 E, Village of Fontana-
on-Geneva Lake, Walworth County, Wisconsin

ORDERED BY:

Delores A. O'Connell
183 Oak St.
Elmhurst, IL 60126

SURVEYED BY:

Jensen Surveying & Mapping S.C.
45 S. Wisconsin St. P.O. Box 322
Elkhorn, Wisconsin. 53121
(414) 723-3434

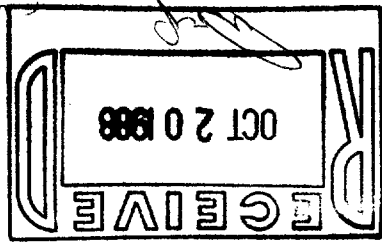

Copyright © 1988 by Jensen Surveying & Mapping S.C.

All rights reserved. No part of this survey plat may be reproduced or transmitted in any form by any means - graphic, electronic, or mechanical, including photocopying, tracing, or information storage and retrieval systems - without permission in writing from Thomas P.A. Jensen, Jensen Surveying & Mapping S.C.

LEGEND


- Found iron pipe
- Found iron pin
- () Recorded dimension

Bearings
referenced
to the
West line
of Hazel
Court
recorded
as NORTH



SCALE: 1" = 20'

Mapping Date:
August 1, 1988

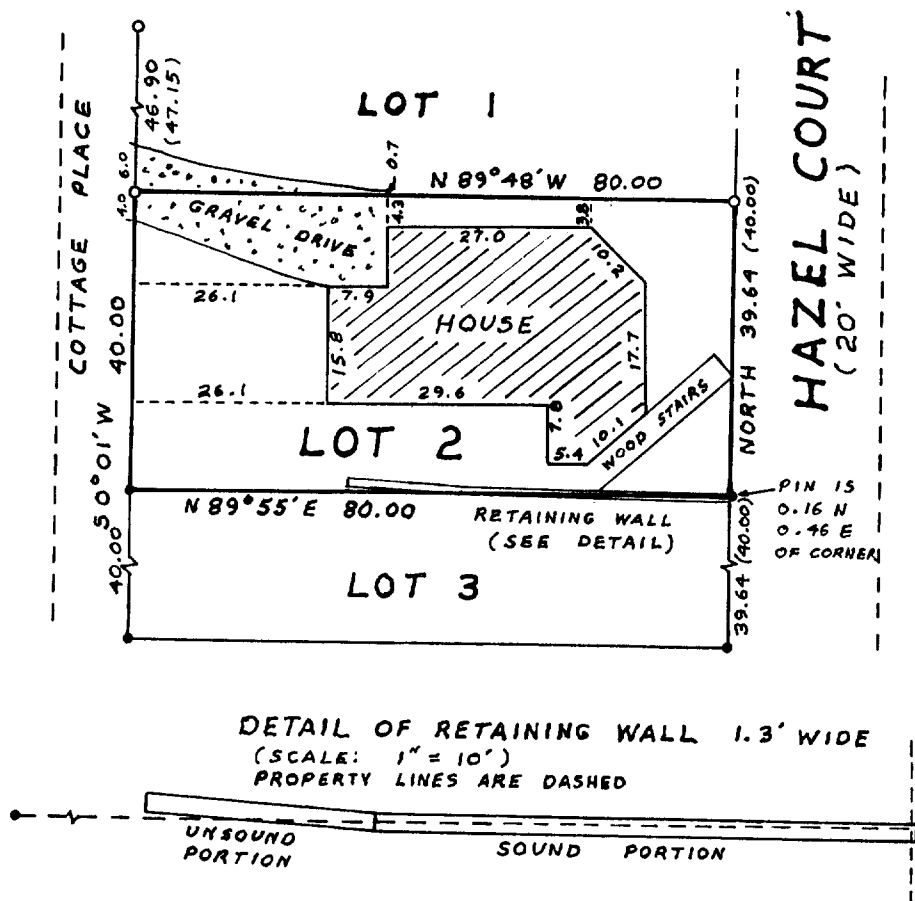

I, Thomas P.A. Jensen, Wisconsin Registered Land Surveyor, do hereby certify that this survey was performed by me, or under my direction, in full compliance with the owner's/agent's instructions and Chapter A-E 5 of the Wisconsin Administrative Code "Minimum Standards For Property Surveys"; and that this map is an accurate representation thereof to the best of my knowledge and belief.

Note: This survey plat is not certified unless signed and sealed in red ink.

Thomas P.A. Jensen R.L.S-1084
Jensen Surveying & Mapping S.C.