


2554 N. 100TH STREET P.O. BOX 26596 **WAUWATOSA, WISCONSIN 53226** (414) 257-2212


## PLAT OF SURVEY

3 and 4, BLOCK 5, INDIAN HILLS, according to the recorded plat thereof, in the Village of Fontana, Walworth County, Wisconsin.



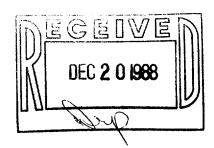

WIDE

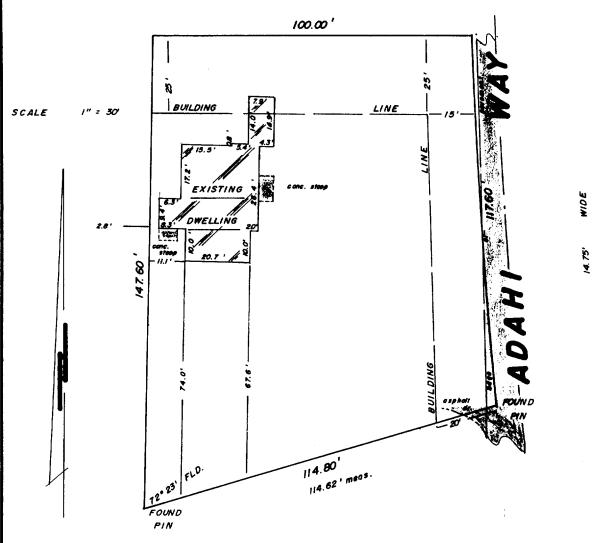



Surveyed for: DONALD E. JOYCE

"I hereby certify that I have surveyed the above described property and that the above map is a true representation thereof and shows the size and location of the property, its exterior boundaries, the location of all visible structures and dimensions of all principal buildings thereon, boundary fences, apparent easements, roadways and encroachments,

"This survey is made for the use of the present owners of the property, and also those who purchase, mortgage, or guarantee the title thereto within one year from date hereof."

MONUMENTATION BY WRITTEN AGREEMENT WITH THE ABOVE NAMED CLIENT HAS WARD BEEN WAIVED IN ACCORDANCE WITH A-E 5.01 (1) (b) OF THE WISCONSIN ADMINISTRATIVE CODE.

NOTE: THIS IS NOT AN ORIGINAL SURVEY UNLESS THIS SEAL IS RED.

REV. 8 - 9 - 88 WISCONSIN REGISTERED LAND SURVEYOR

AUGUST 4,1988

tep IW FIELD WORK BY

DRAWN BY

20218 JOB NUMBER

5-909

DATE