


GENEVA


LAKE

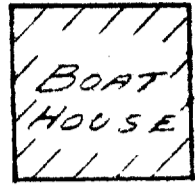

PARK

PARK

PLACE

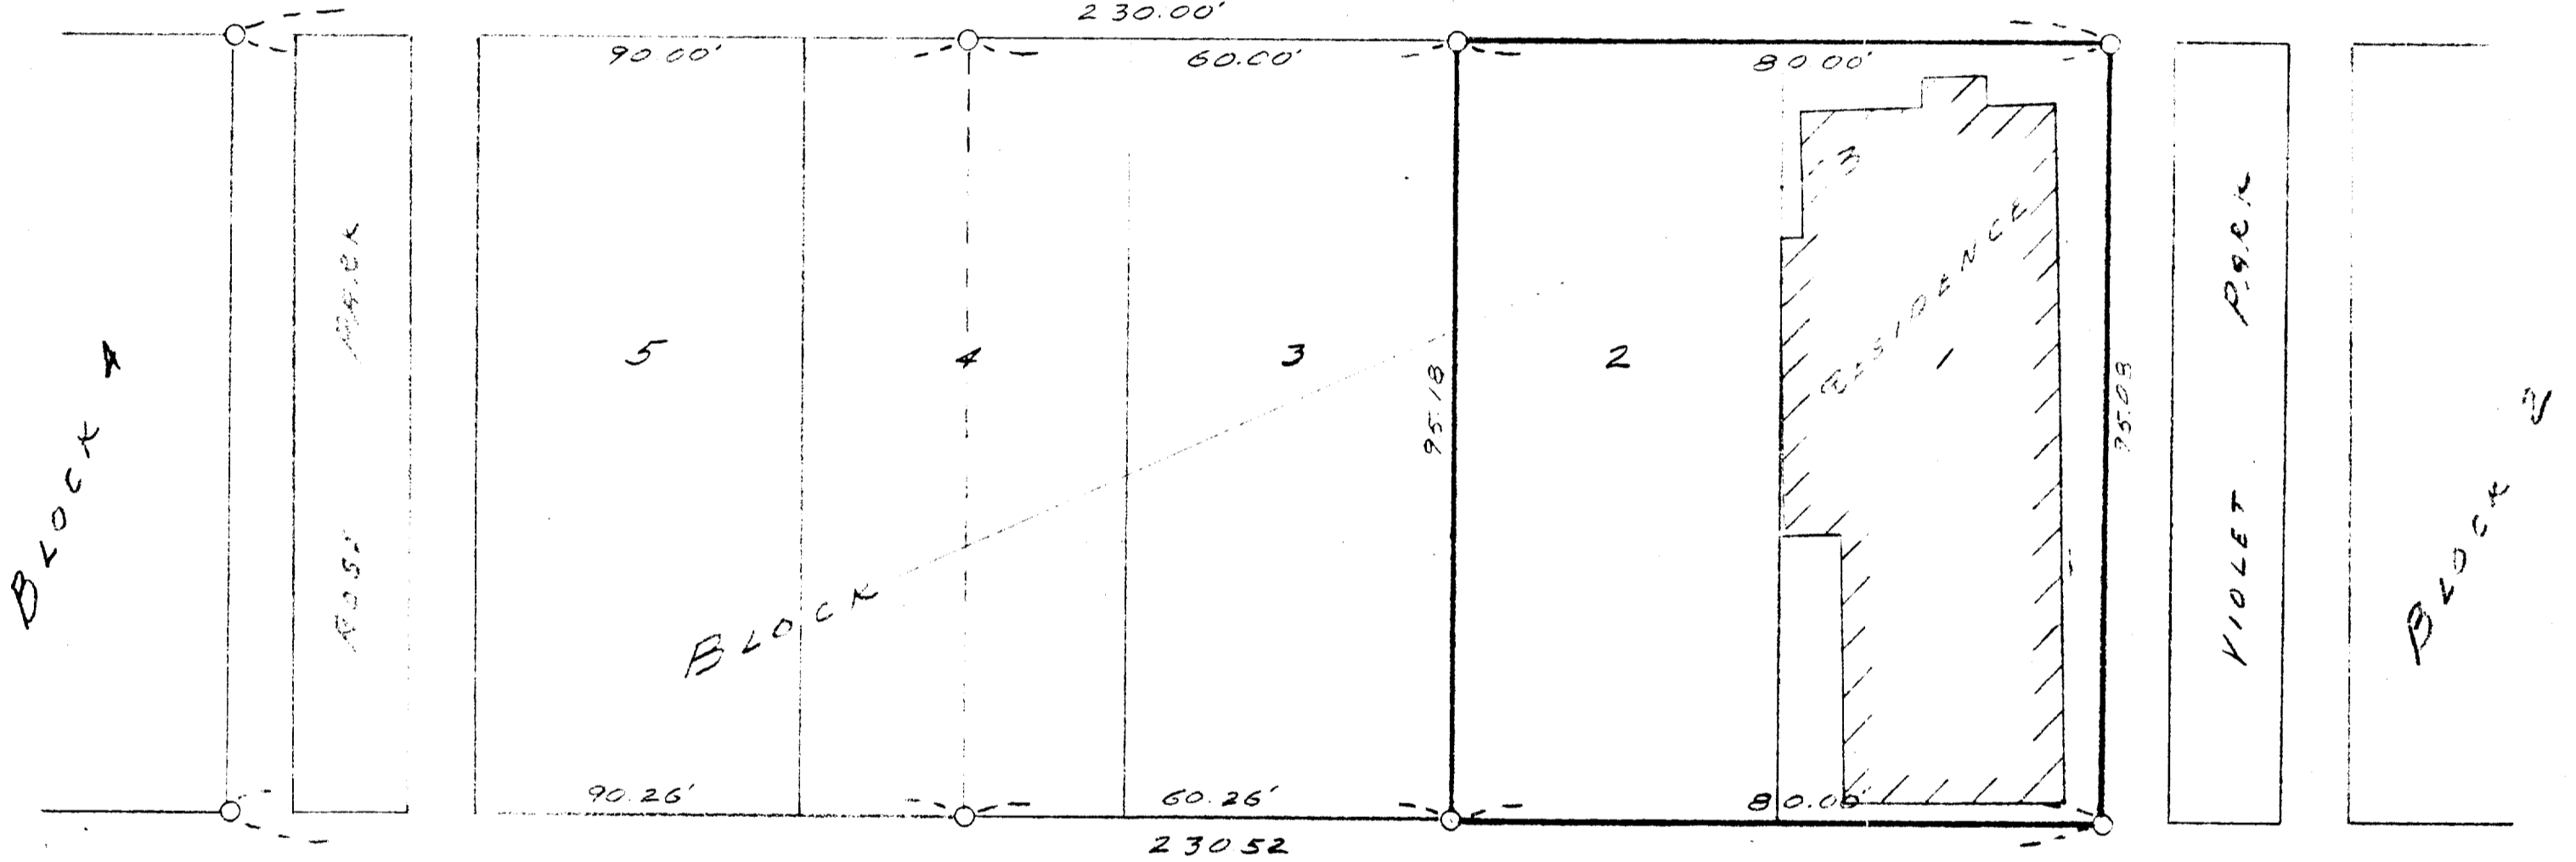

HARVARD

AVENUE

LINDEN AVE

ELM AVE

1A

BLOCK

o = IRON PIPE



PLAT OF SURVEY

OF

LOT 1 AND LOT 2

OF

BLOCK 3

GLENWOOD SPRINGS SUBDIVISION

WILMOUTH CO., WISCONSIN

Floyd L. Jensen
SURVEYOR

SCALE 1" = 20'

DATE JULY 1953

SG 510