


GEORGE T. DUNHAM
SURVEYING & SUBDIVIDING
DELAVER, WISCONSIN

N

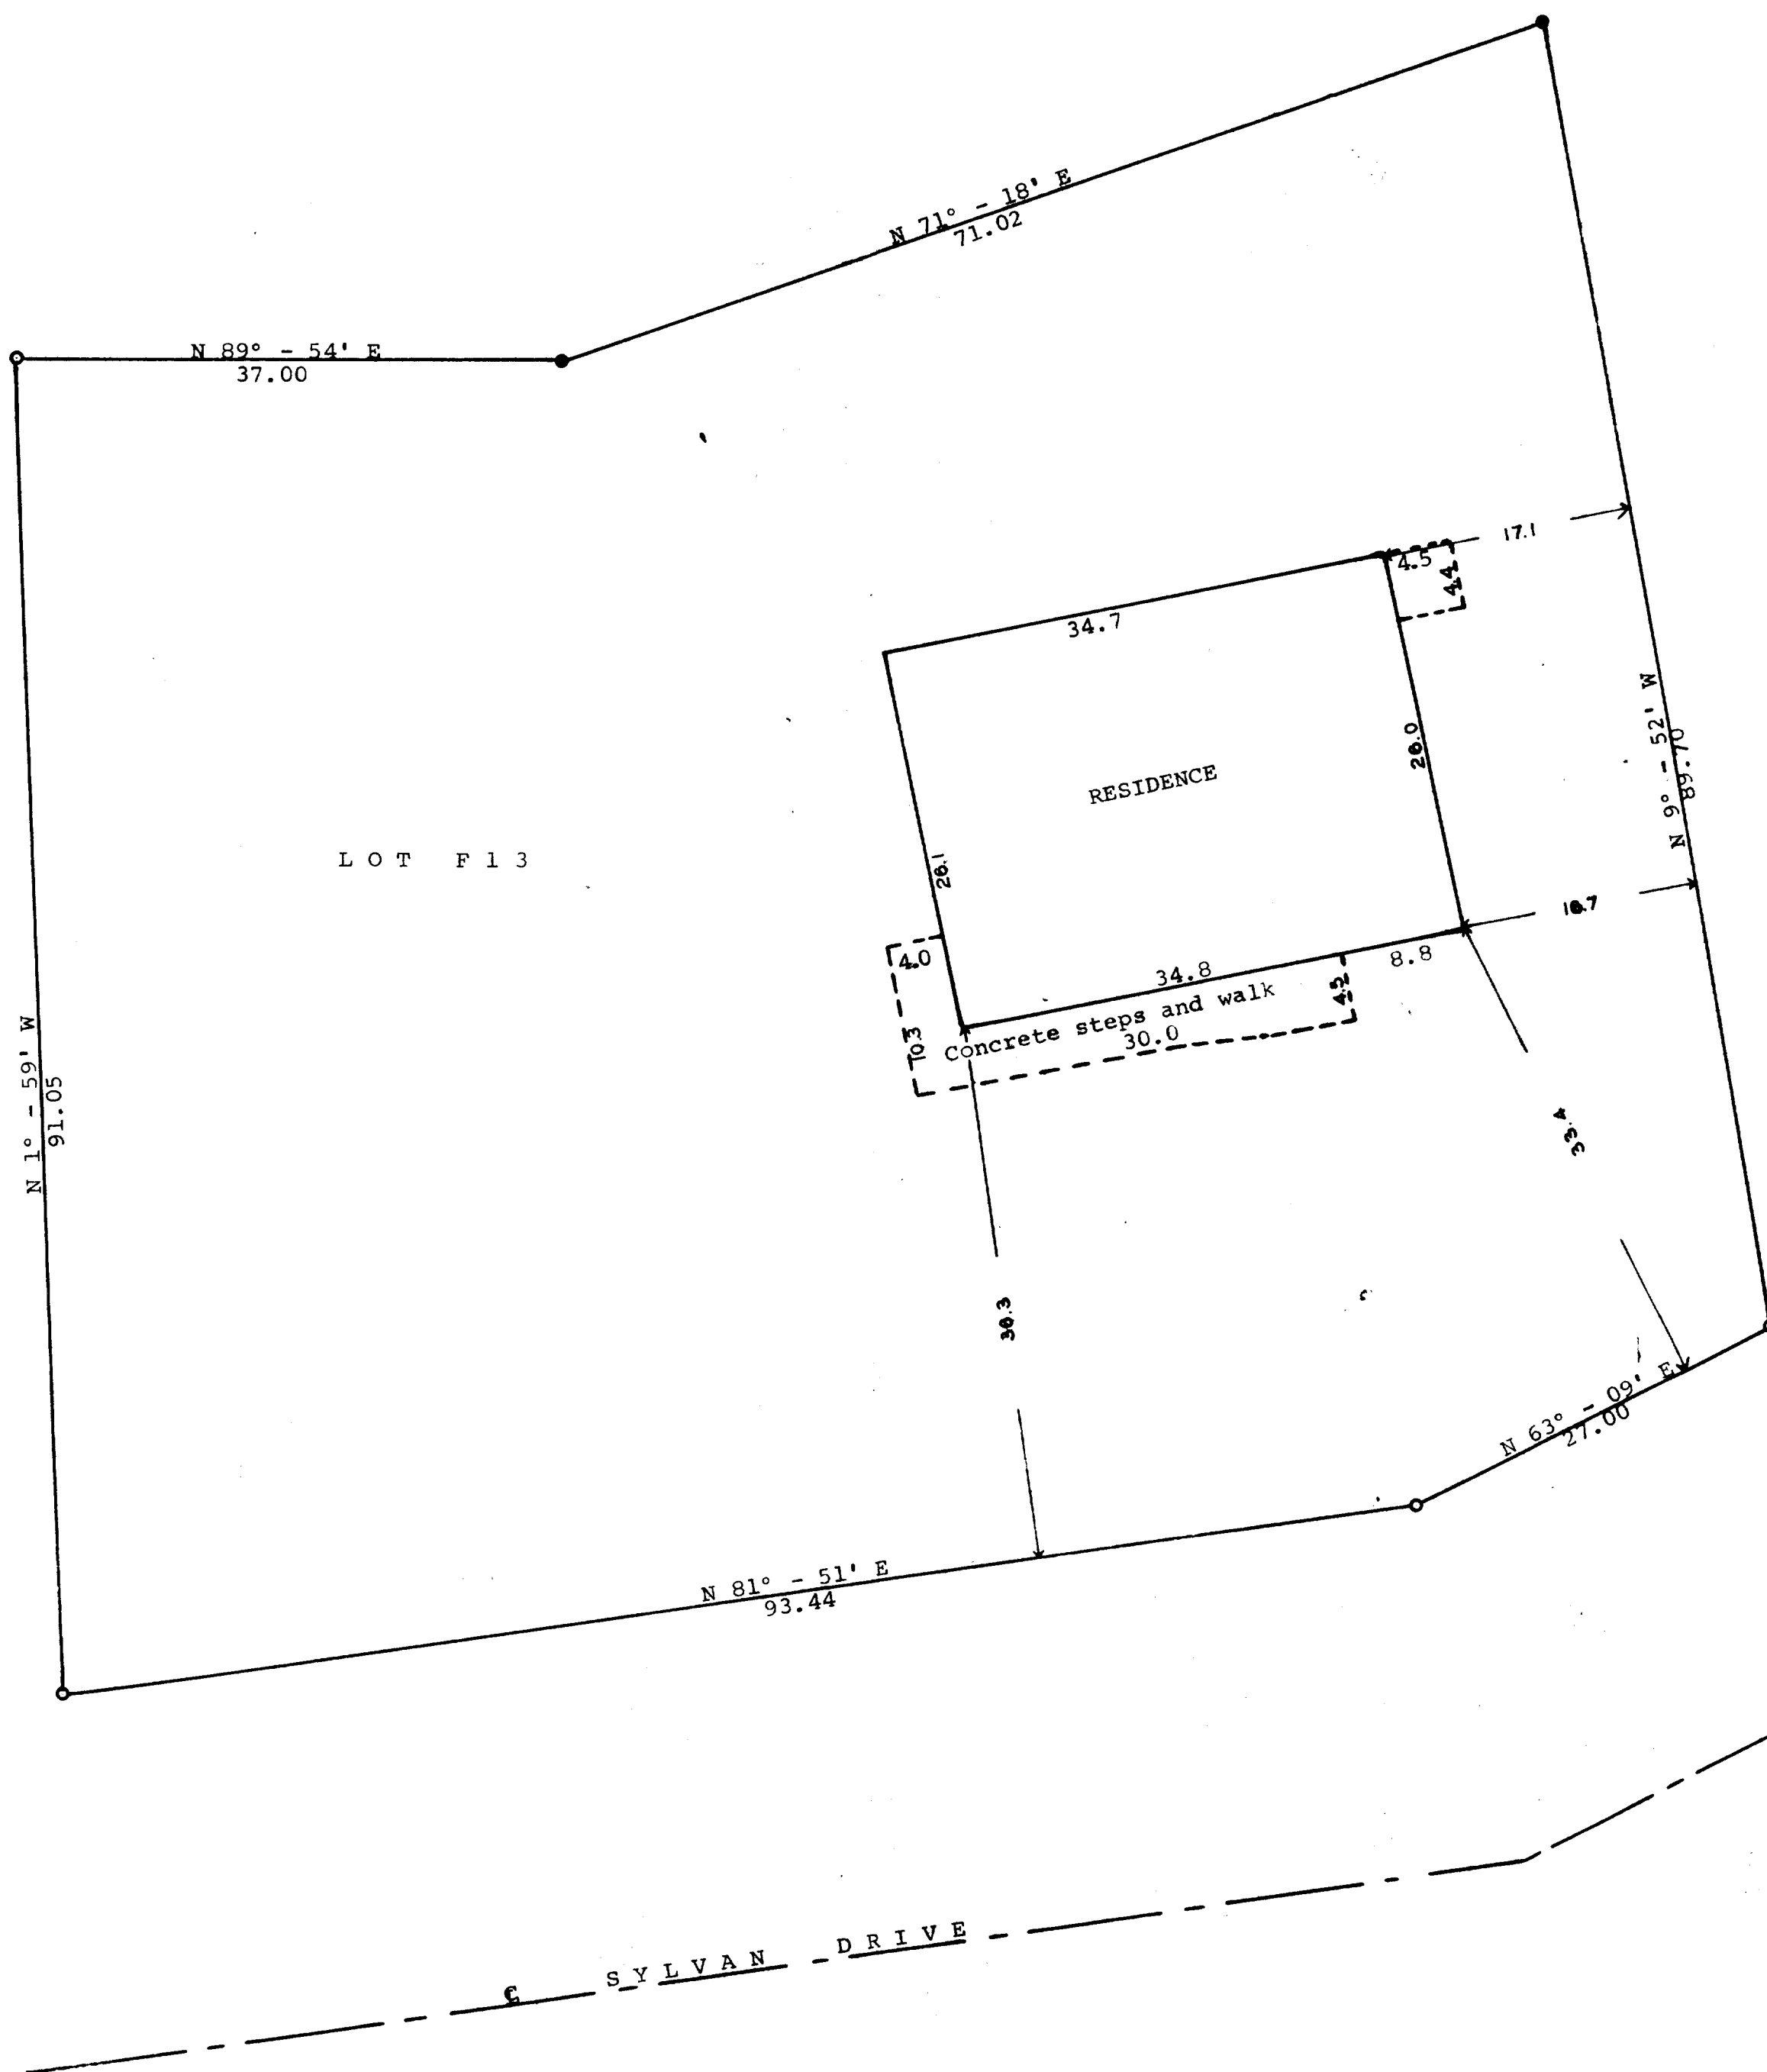

Scale - 1" = 10'

● = Conc. Monument
○ = Iron Pipe

STATE OF WISCONSIN) ss
WALWORTH COUNTY)

I, George T. Dunham, Surveyor, do hereby certify
that I have surveyed the property described as follows,
Lot F13 of the Addition F to Country Club Estates
located in the Village of Fontana, Walworth County,
Wisconsin.

and that the above plat is an accurate survey and a true
representation thereof and correctly shows the exterior
boundary lines and the location of the building on said
property and the correct measurements thereof.

July 23, 1965

George T. Dunham
George T. Dunham, Surveyor