
ABELL SURVEYING & MAPPING DELAYAN, WISCONSIN BELIS

DELAVAN, WISCONSIN 53115 414-728-6787

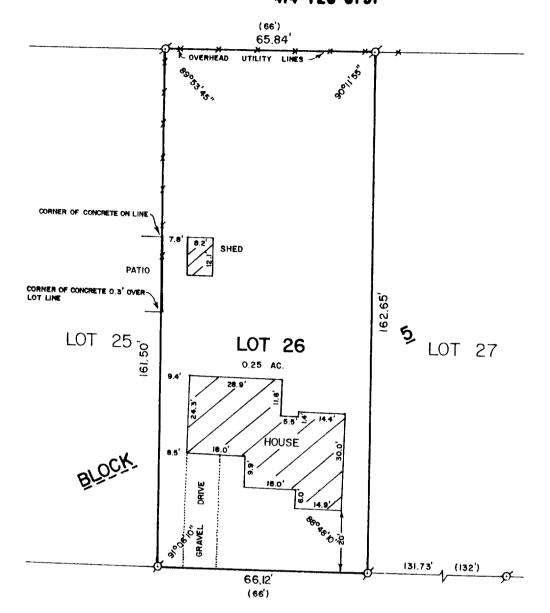

DEWEY


AVENUE

PLAT OF SURVEY OF

LOT 26, BLOCK 5, C. L. DOUGLAS SUBDIVISION, PART OF ASSESSOR'S PLAT NO. 1 OF THE VILLAGE OF FONTANA-ON-GENEVA LAKE, WALWORTH COUNTY, WISCONSIN.

ORDERED BY:

THE RAULAND AGENCY 118 KENOSHA ST. WALWORTH, WI. 53184

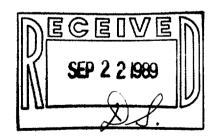



SCALE -1''=30'

I HEREBY CERTIFY THAT I HAVE SURVEYED THE ABOVE DESCRIBED PROPERTY AND THAT THE ABOVE MAP IS A TRUE REPRESENTATION THEREOF AND SHOWS THE SIZE AND LOCATION OF THE PROPERTY, ITS EXTERIOR BOUNDARIES, THE LOCATION OF ALL VISIBLE STRUCTURES AND DIMENSIONS OF ALL PRINCIPAL BUILDINGS THEREON, BOUNDARY FENCES, APPARENT EASEHENTS, ROADWAYS AND VISIBLE ENCROACHMENTS, IF ANY, TO THE BEST OF MY KNOWLEDGE AND BELIEF.

THIS SURVEY 1S MADE FOR THE USE OF THE PRESENT OWNERS OF THE PROPERTY, AND ALSO THOSE WHO PURCHASE, MORTGAGE, OR GUARANTEE THE TITLE THERETO WITHIN ONE (1) YEAR FROM DATE HEREOF.

Sand 7. abell

DAVID F. ABELL
WISCONSIN REGISTERED LAND SURVEYOR, S-1596

August 11, 1989

NOTE: THIS IS NOT A CERTIFIED COPY UNLESS SEALED. 89160

STEV-250