


## SURVEYING & SUBDIVIDING

N

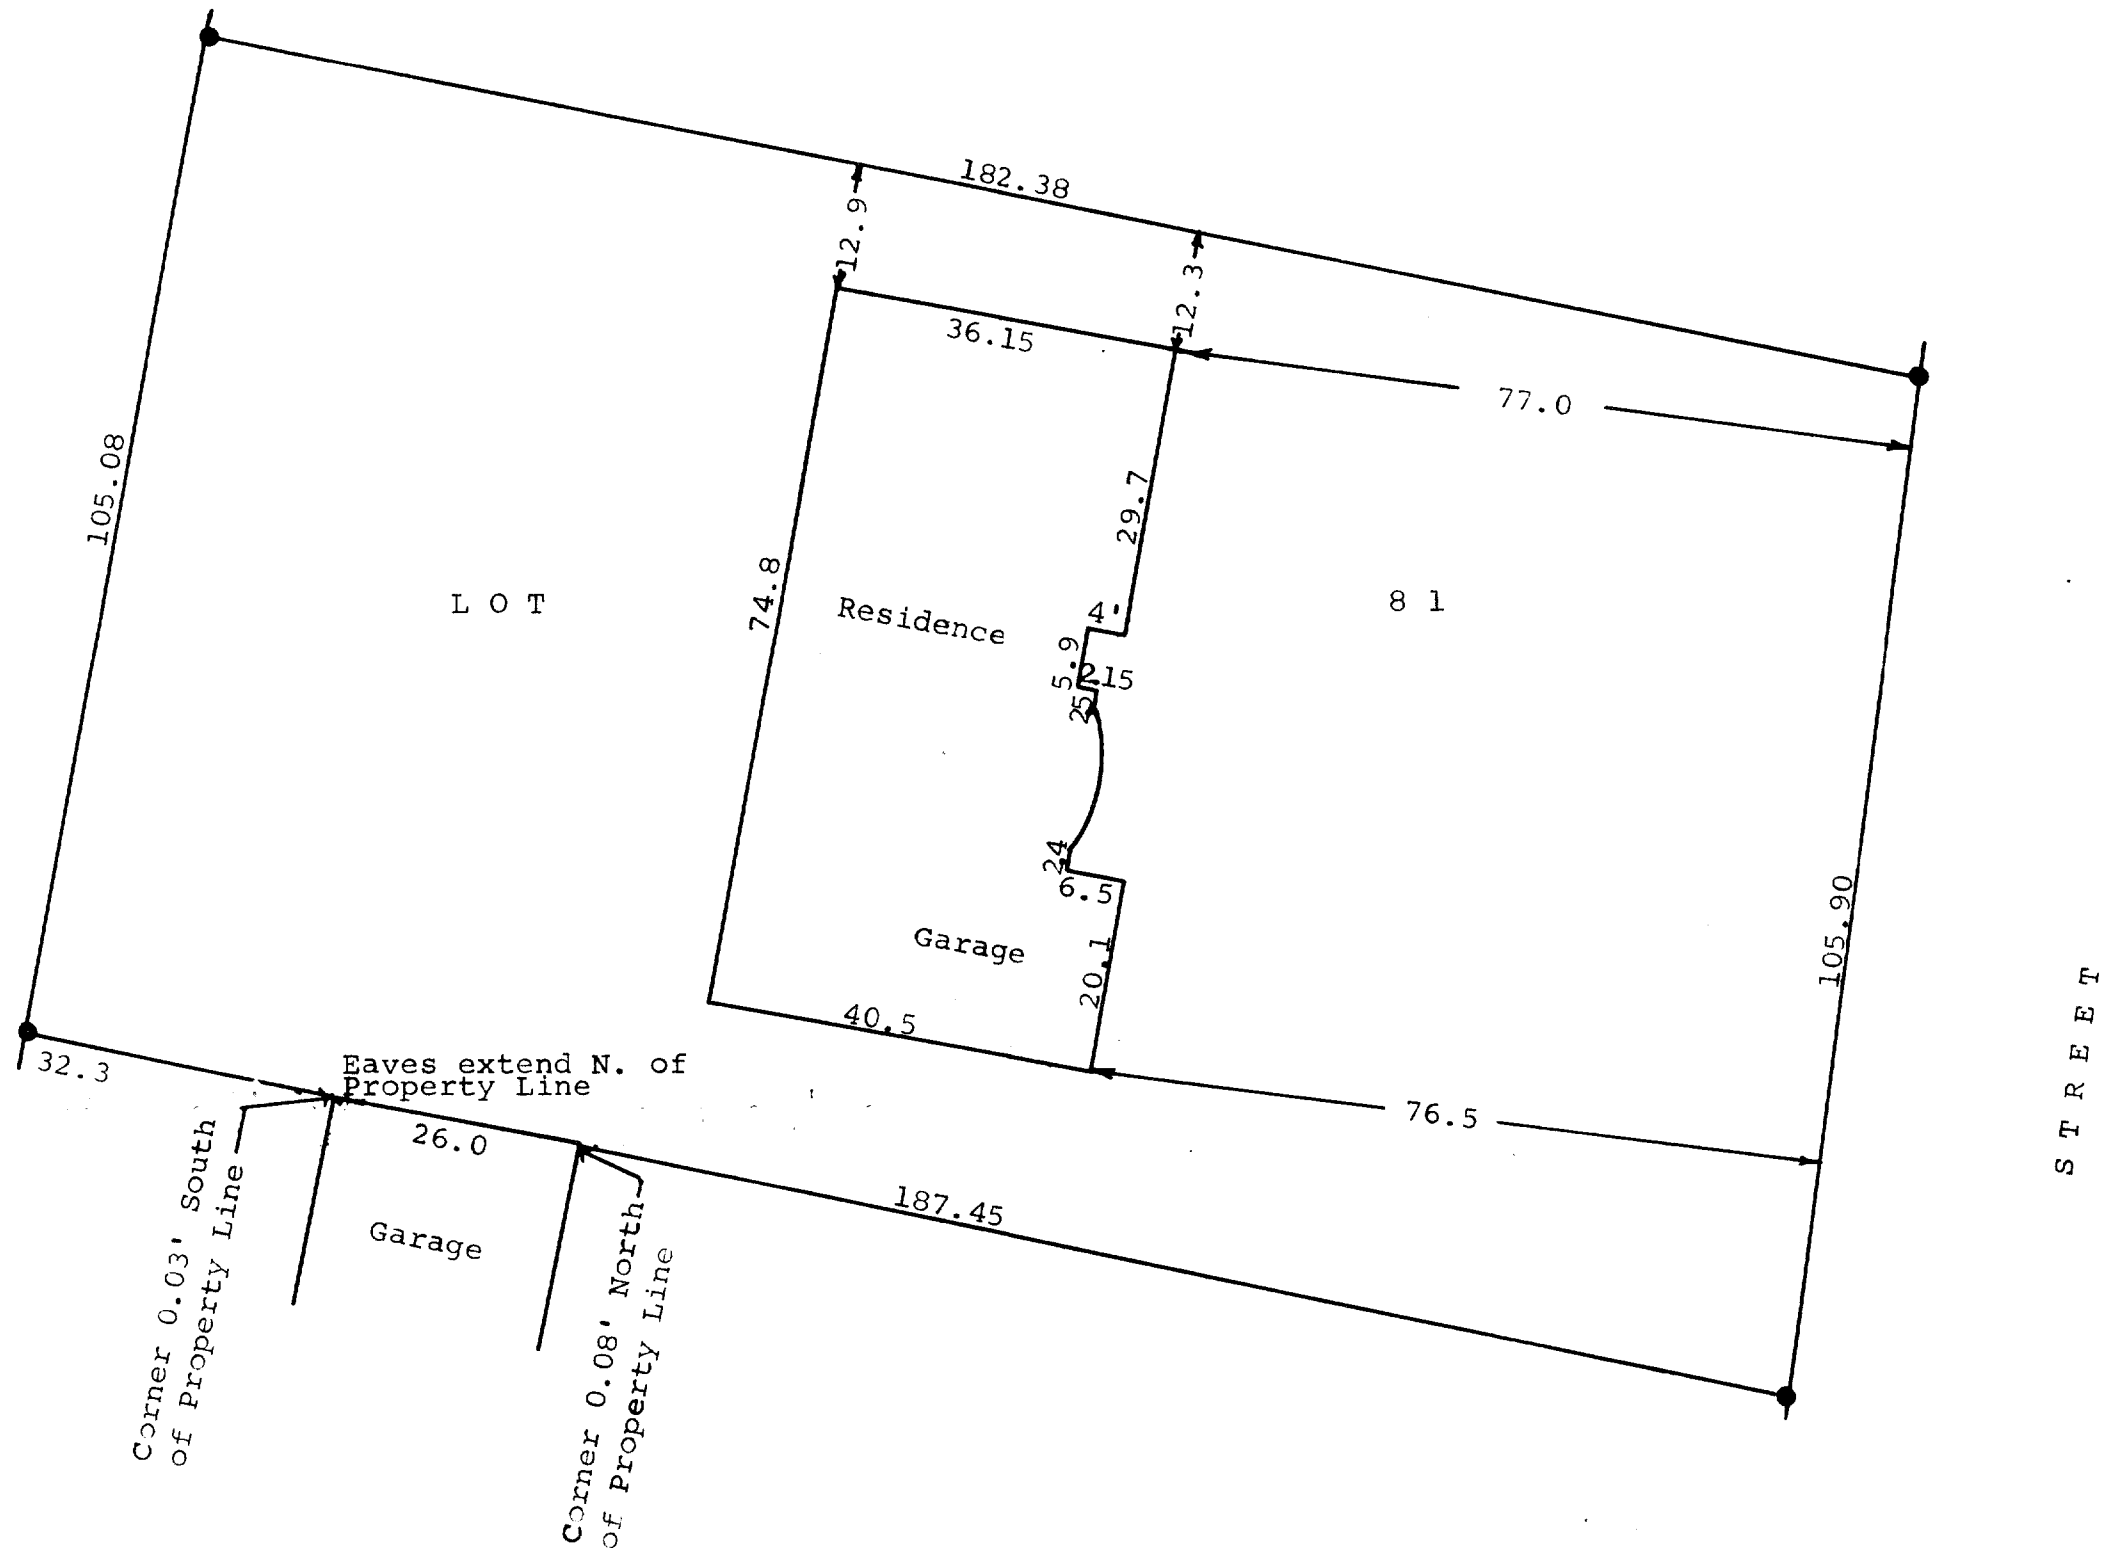

George T. Dunham  
George T. Dunham, Surveyor

5-97

SC02-76