


FEATHERSTON DRIVE

N 5° 15' W 90.00'

N 74° 36' E 116.26'

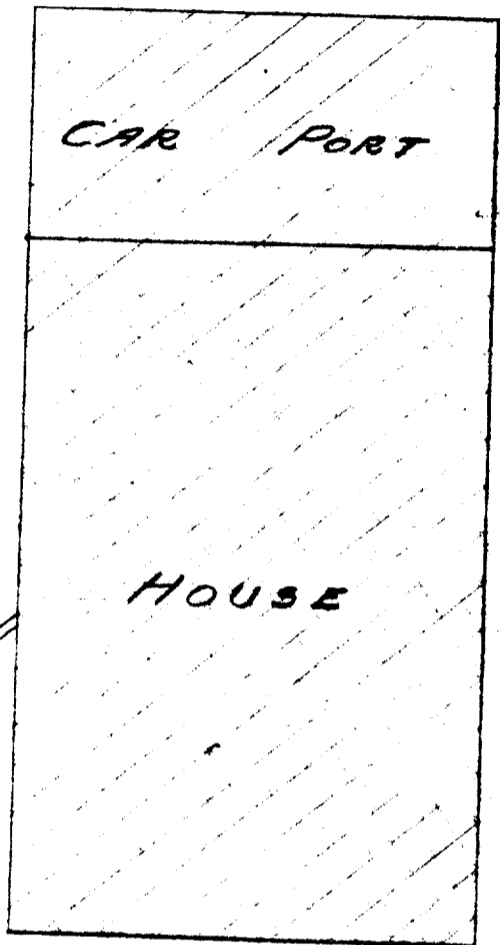

SEPTIC TANK

DRAINAGE

N 0° 37' W 108.00'

N

N 83° 13' E 105.73'

o = IRON PIPE

STATE OF WISCONSIN)
WALWORTH COUNTY) SS

I, LLOYD L. JENSEN, DO HEREBY CERTIFY THAT I HAVE SURVEYED THE PROPERTY DESCRIBED HEREON ACCORDING TO THE OFFICIAL RECORDS, AND THAT THE PLAT ABOVE IS A CORRECT REPRESENTATION OF THE LOT LINES AND PRINCIPAL LINES OF BUILDINGS THEREON.

ELKHORN, WISCONSIN.

JUNE 1953

Lloyd L. Jensen
COUNTY SURVEYOR

PLAT OF SURVEY
OF

LOT 4

OF

ADDITION "A"
TO COUNTRY CLUB ESTATES
WALWORTH CO, WISCONSIN

Lloyd L. Jensen
SURVEYOR

SCALE 1" = 40'

5-98J

DATE JUNE 1953

50TA-4