



Plat of Survey

of

Center 1/4 Corner
Section 35-1-18.

A parcel of land described in Document recorded in Vol. 580 on Page 336 as Document No. 238101 as shown below:
All the following described real estate except the N. 99.5 ft. thereof, beginning at the S 1/4 corner of Sec. 35 T. 1 N. R. 18 E. of the 4th P.M., Township of Bloomfield, County of Walworth, State of Wisconsin, run thence N. on the N. and S. 1/4 Section line 500.00 ft. to a point, said point marks the place of beginning of parcel of land hereinafter described, run thence S. 89 deg. 58' W. 200.00 ft. to a point, thence S. 187.15 ft. to a point, thence S. 34 deg. 04' W. 15.52 ft. to a point, thence N. 89 deg. 58' E. 206.85 ft. to a point, thence N. 34 deg. 04' E. 3.29 ft. to a point, thence N. 197.28 ft. to a point and the place of beginning, said parcel of land is located in the SW 1/4 of Sec. 35, T. 1 N. R. 18 E. of the 4th P.M., Township of Bloomfield, County of Walworth, State of Wisconsin.

Surveyed for: **Dennis & Kathy Pierce**
41 Fellows Street
Genoa City, Wisconsin. 53128

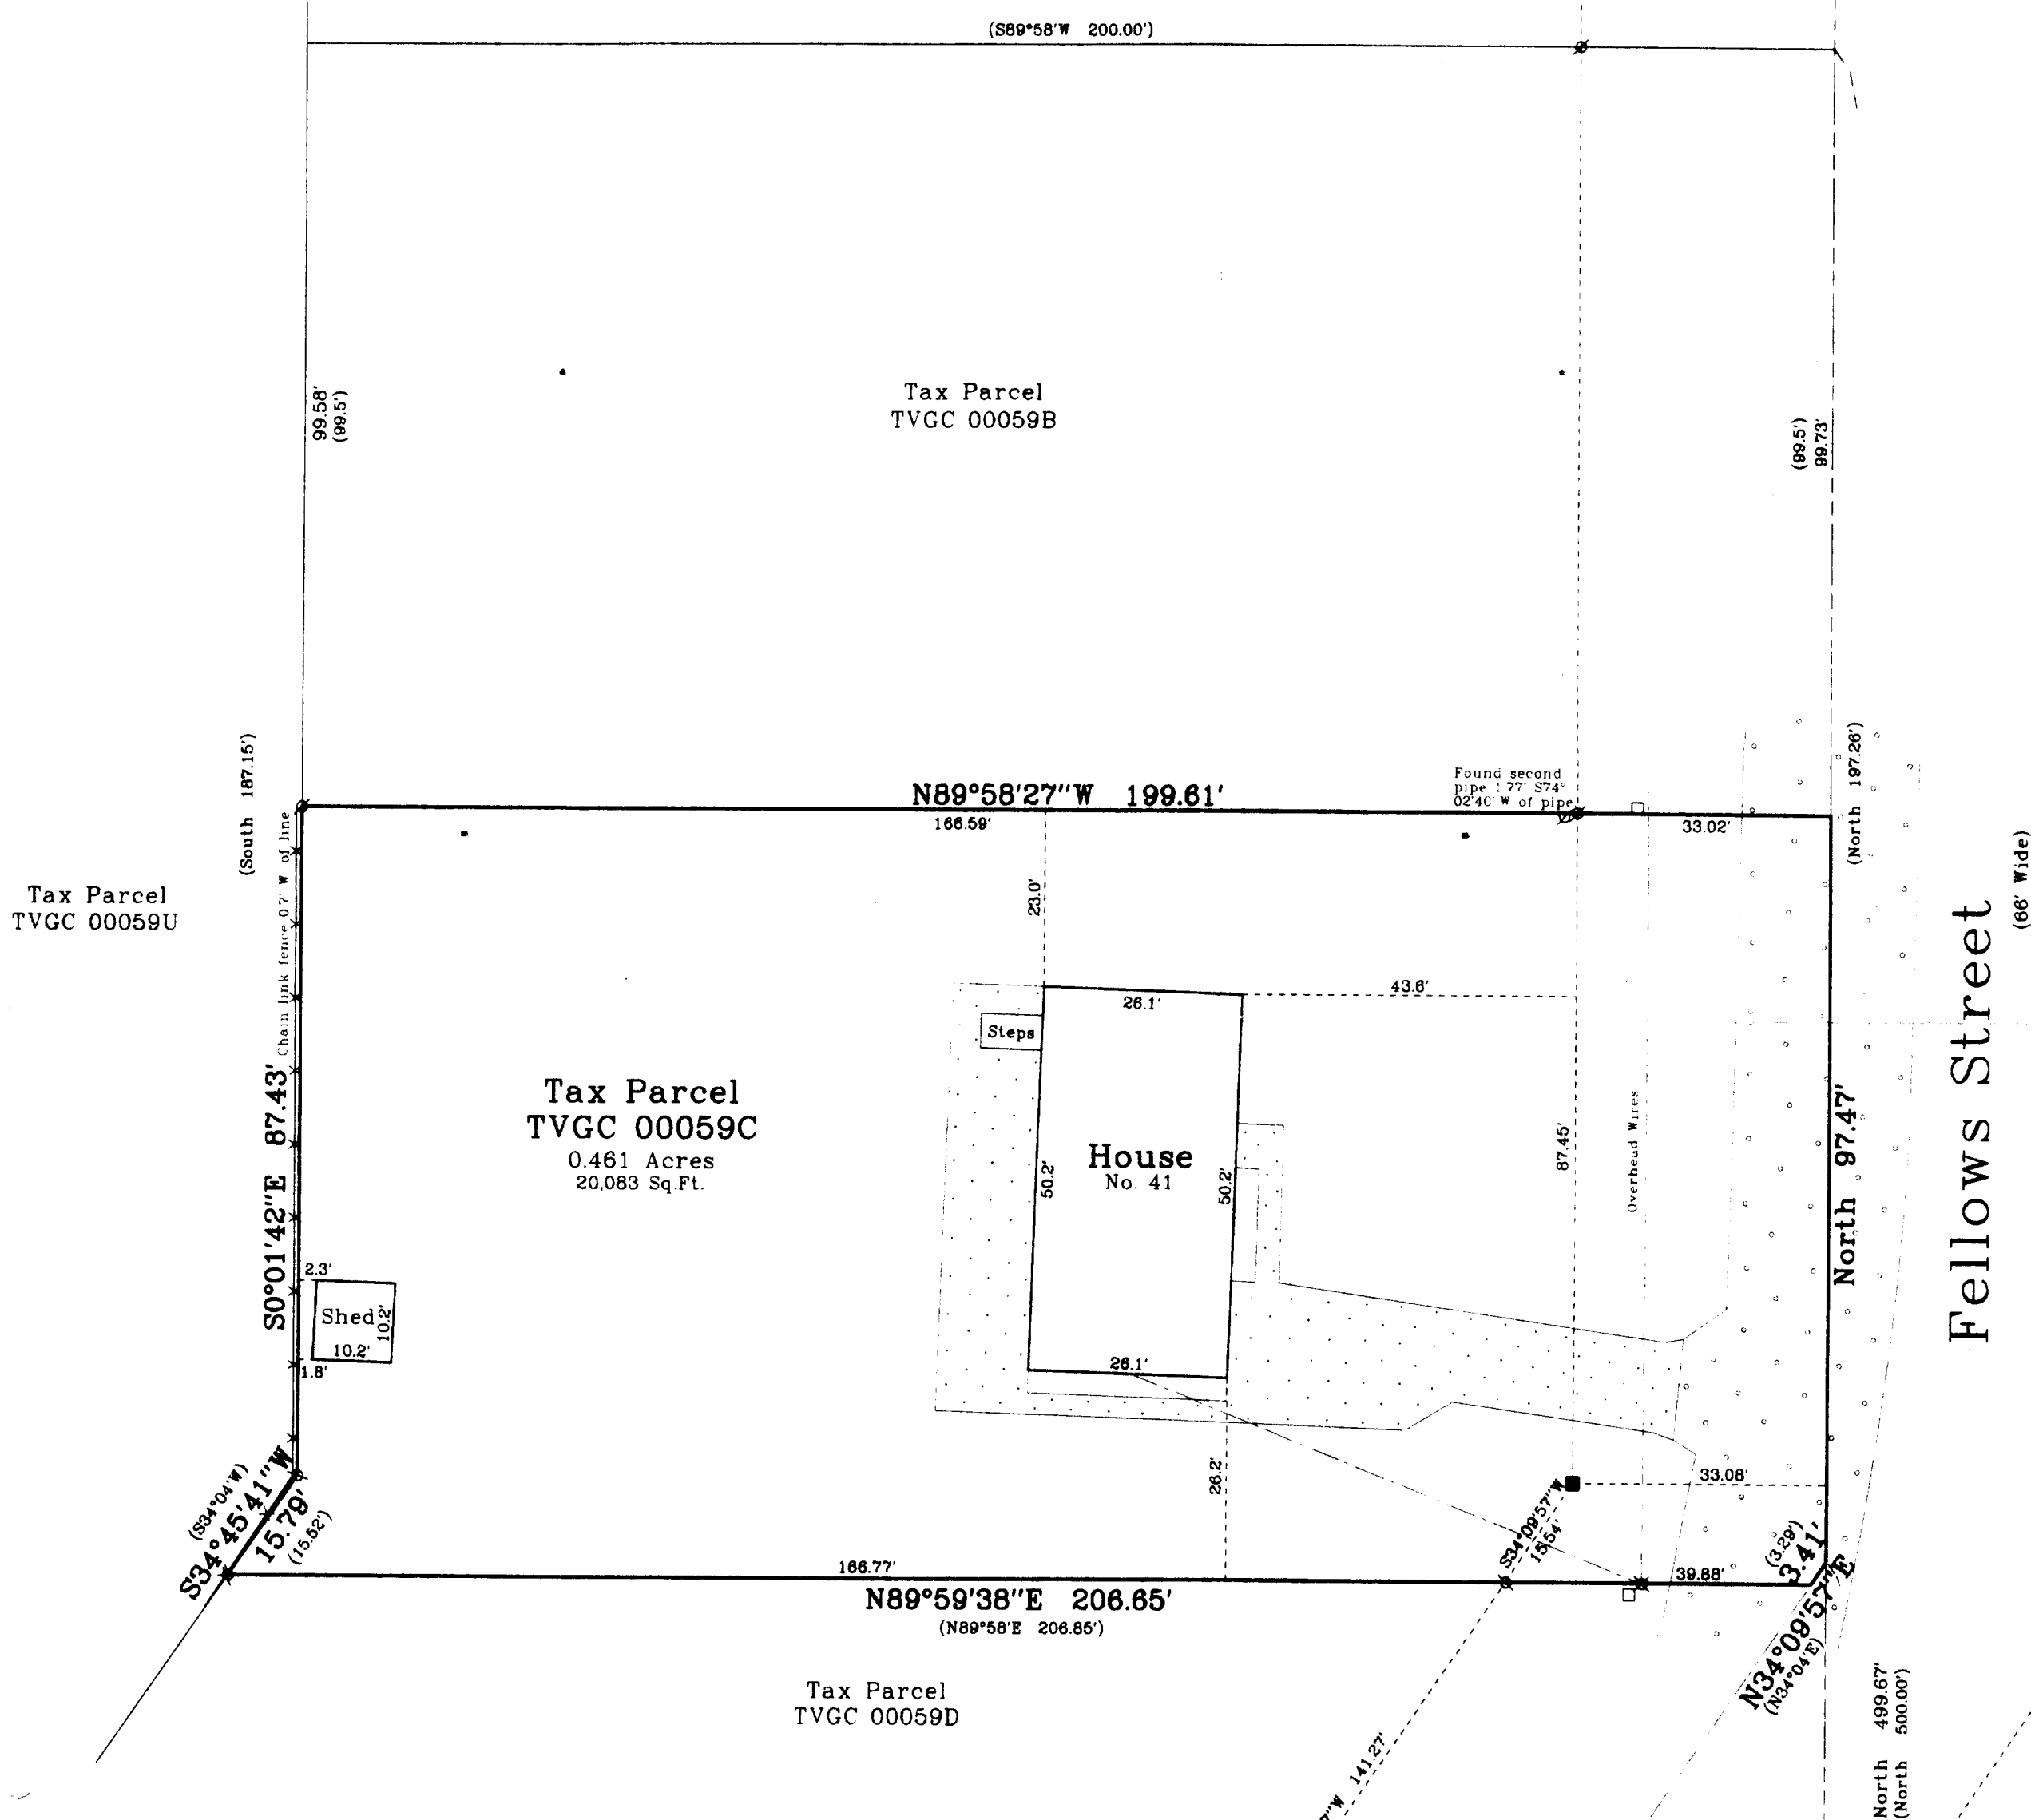
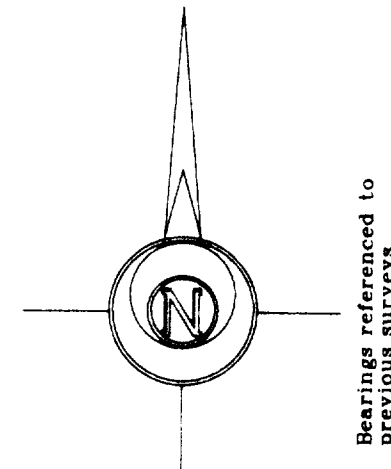


Copyright © 2002 by Jensen & Olson Land Surveying, LLC.

All rights reserved. No part of this survey plat may be reproduced or transmitted in any form by any means - graphic, electronic, or mechanical, including photocopying, tracing, or information storage and retrieval systems - without permission in writing from Douglas G. Olson, Jensen & Olson Land Surveying, LLC.

I hereby certify that I have surveyed the above described property and the map hereon is correct to the best of my professional knowledge and belief, and shows the size and location of the property, its exterior boundaries, the location and dimensions of all visible structures thereon, boundary fences, apparent easements and roadways and visible encroachments, if any.
This survey is made for the exclusive use of the present owners of property, and also those who purchase, mortgage or guarantee title thereto, within one year from the date hereof.

Douglas G. Olson
Wisconsin Registered Land Surveyor - 2093

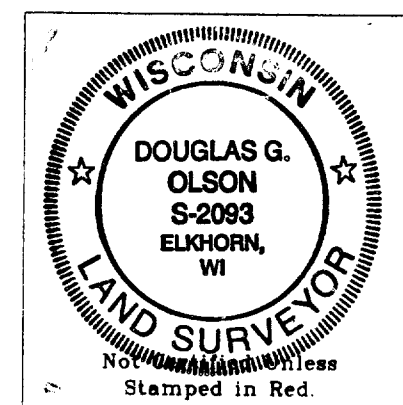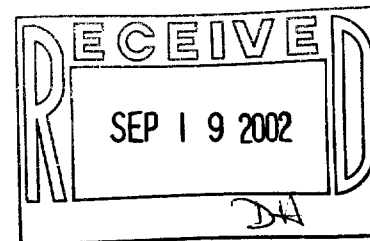

Notes:

- 1) This survey plat is not certified unless signed and sealed in red ink.
- 2) This survey is subject to Wisconsin lien laws. This Plat of Survey is the notice of intent to file lien. Lien waiver required.

2001.178

Sheet 1 of 1 Sheets

Job Reference Number

2001.178

Legend


- Found County Section Corner
- Found Concrete Monument
- Found Iron Pipe
- () Recorded Information
- ⊗ Utility Pole
- Utility Pedestal
- ▨ Concrete Surface
- ▩ Asphalt

Jensen & Olson Land Surveying, LLC

45 South Wisconsin Street P.O. Box 322
Elkhorn, Wisconsin. 53121
Telephone (262) 723-3434
Facsimile (262) 723-8044

Scale in Feet

1" = 20'

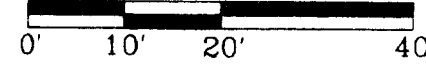

Survey Date: December 20, 2001

Revisions: