## FARRIS, HANSEN & ASSOCIATES, INC.

ENGINEERING, ARCHITECTURE, SURVEYING 7 RIDGEWAY COURT - P.O. BOX 437, ELKHORN, WISCONSIN, 53121 (262) 723-2098 FAX: (262) 723-5886 PHONE:


## PLAT OF SURVEY

## LOT 240 OF HUNTERS RIDGE SUBDIVISION ADDITION NO. 1

LOCATED IN PART OF THE NW 1/4 & SW 1/4 OF THE NW 1/4 OF

FOUND IRON REBAR STAKE FOUND CONCRETE COUNTY MONUMENT SECTION 36, TOWN 1 NORTH, RANGE 18 EAST

VILLAGE OF GENOA CITY, WALWORTH COUNTY, WISCONSIN

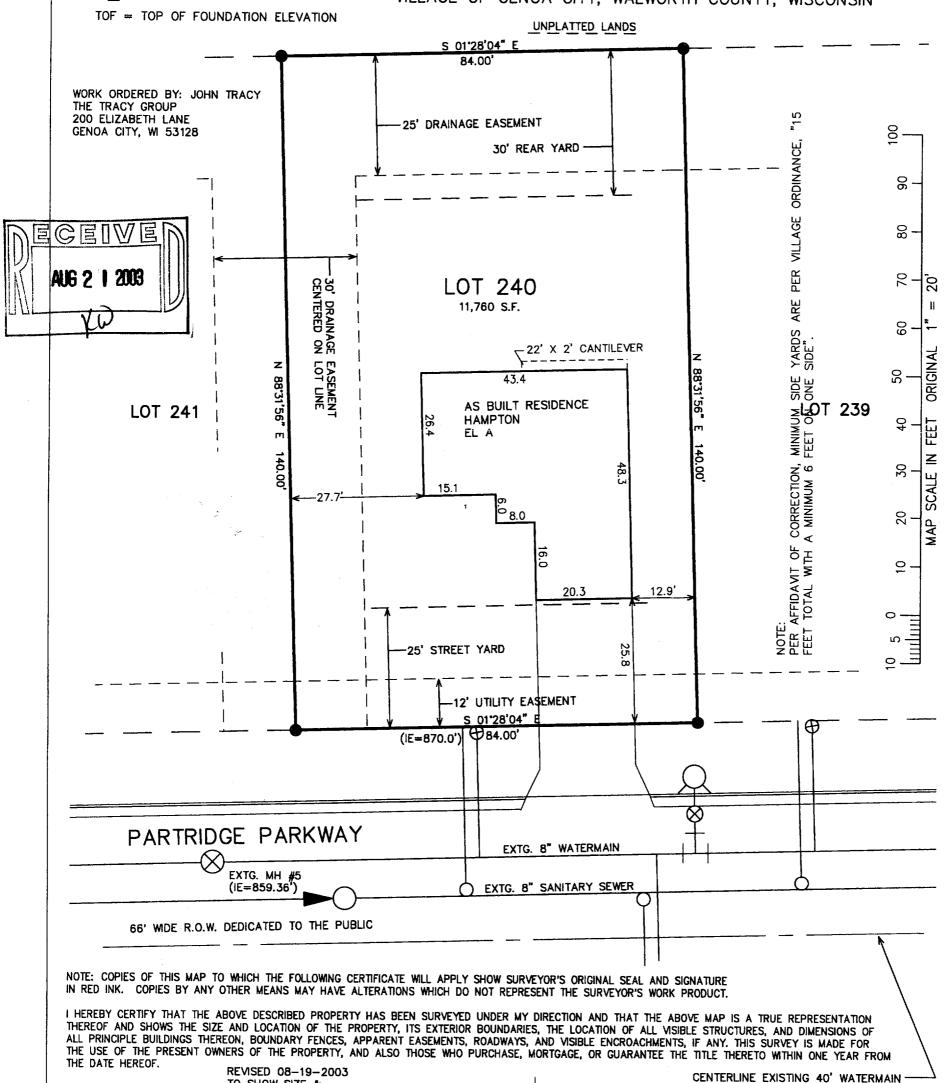

AS BUILT

TO SHOW SIZE &

LOCATION OF RESIDENCE

ASSIGNED NORTH LINE OF THE NW 1/4 OF 36-1-18 N 88°42'17" E (BEARING PER RECORD PLAT OF HUNTERS RIDGE SUBDIVISION)

PROJECT 4939.240

SHEET 1 OF 1

THR1-41

DATED: MAY 29, 2003

PETER S. GORDON R.L.S. 2101

AND SANITARY SEWER EASEMENT

**DOCUMENT NO. 383209** 

RECORDED IN VOLUME 256, PAGE 8787,