
## PLAT OF SURVEY

-0F-

A PARCEL OF LAND LOCATED IN THE VILLAGE OF GENOA CITY, IN THE SOUTHEAST QUARTER OF SECTION 35, TOWN 1 NORTH, RANGE 18 EAST OF THE FOURTH PRINCIPAL MERIDIAN, WALWORTH COUNTY, WISCONSIN, DESCRIBED AS FOLLOWS. TO-WIT: COMMENCING AT THE SOUTHEAST CORNER OF ZARNSTORFF'S ADDITION, ACCORDING TO THE PLAT THEREOF ON RECORD IN THE OFFICE OF THE REGISTER OF DEEDS IN AND FOR WALWORTH COUNTY, WISCONSIN: THENCE SOUTH 205 FEET TO THE PLACE OF BEGINNING: THENCE CONTINUING SOUTH 180 FEET TO THE PIPE: THENCE WEST 95 FEET TO A PIPE: THENCE NORTH 180 FEET TO A PIPE; THENCE EAST TO THE PLACE OF BEGINNING, ALL IN THE VILLAGE OF GENOA CITY, WALWORTH COUNTY, WISCONSIN.

SURVEY FOR: Remax Southern Lakes/Mike

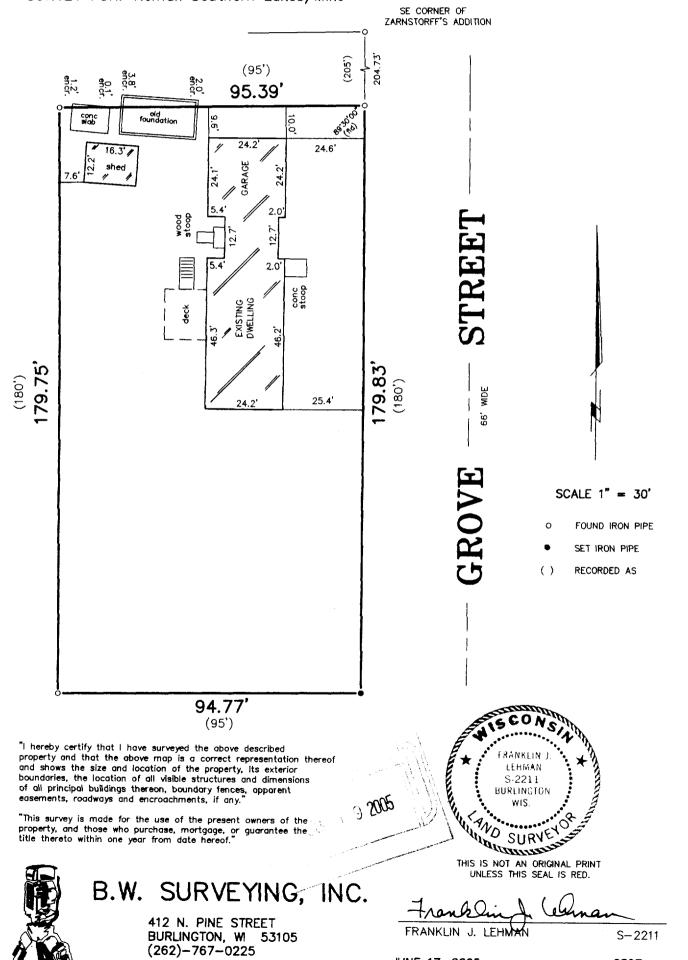

S-2211

6897

JOB NUMBER

FRANKLIN J. LEHMAN

JUNE 17, 2005

DATE