PLAT OF SURVEY

PREPARED FOR: ANN BALTYS -OF-

COMMENCING AT THE NORTHEAST CORNER OF THE SOUTHEAST 1/4 OF THE SOUTHWEST 1/4, SECTION 35, TOWN 1 NORTH, RANGE 18 EAST, THENCE SOUTH 89°37' WEST 363 FEET; THENCE SOUTH 0°30'00" WEST 280.11 FEET; THENCE NORTH 67°30' WEST 195 FEET; THENCE NORTH 0°30'00" WEST 190.14 FEET TO THE PLACE OF BEGINNING; THENCE SOUTH 0°30'00" EAST 204.37 FEET TO THE CENTERLINE OF MAIN STREET; THENCE SOUTH 65°20'02" EAST ALONG SAID CENTERLINE 100.66 FEET; THENCE NORTH 0°26'49" WEST 232.82 FEET TO THE 1/8th SECTION LINE; THENCE SOUTH 89°34' 38" WEST 91.32 FEET TO THE PLACE OF BEGINNING, SAID LAND LYING AND BEING IN THE VILLAGE OF GENOA CITY, WALWORTH COUNTY, WISCONSIN.

PATHFINDER SURVEYING INC.

(formerly)


J.K. SURVEYING INC.

P.O BOX 322

LAKE GENEVA, WI. 53147

WWW.PATHFINDERSURVEYING.NET

262-248-8303

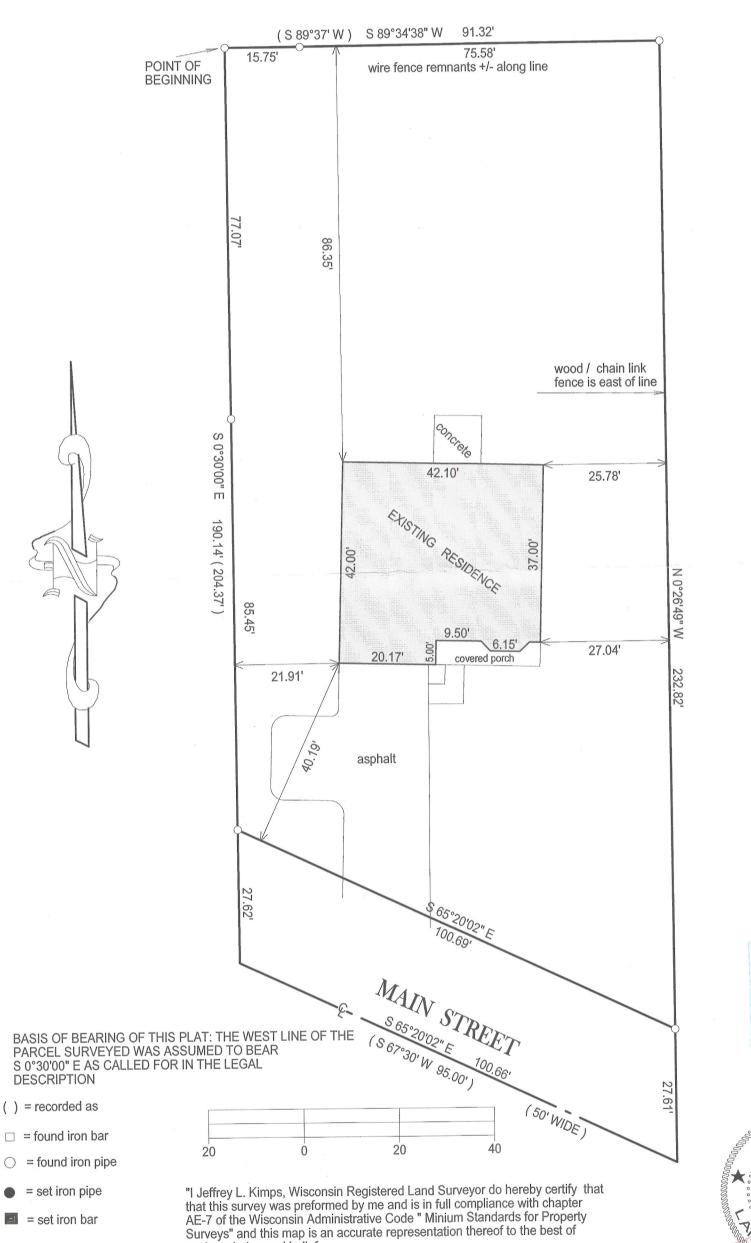

my knowledge and belief.

the date hereof.

This survey is made for the present owners of the property, and those who purchase, mortgage, or guarantee the title thereto, within one year from

DATED THIS 12TH DAY OF SEPTEMBER, 2012.

SCALE: 1" = 20'

JOB #: 12-135

TAX ID #: TVGC 00058A1





JEFPREY L KIMPS S 2436 Wisconsin Registered Land Surveyor (original if signed in red)