


KOLB LAND CONSULTING, INC.
LAND SURVEYING • SUBDIVIDING • LAND PLANNING

LAKE GENEVA, WISCONSIN 53147

WHITEWATER, WISCONSIN 53190

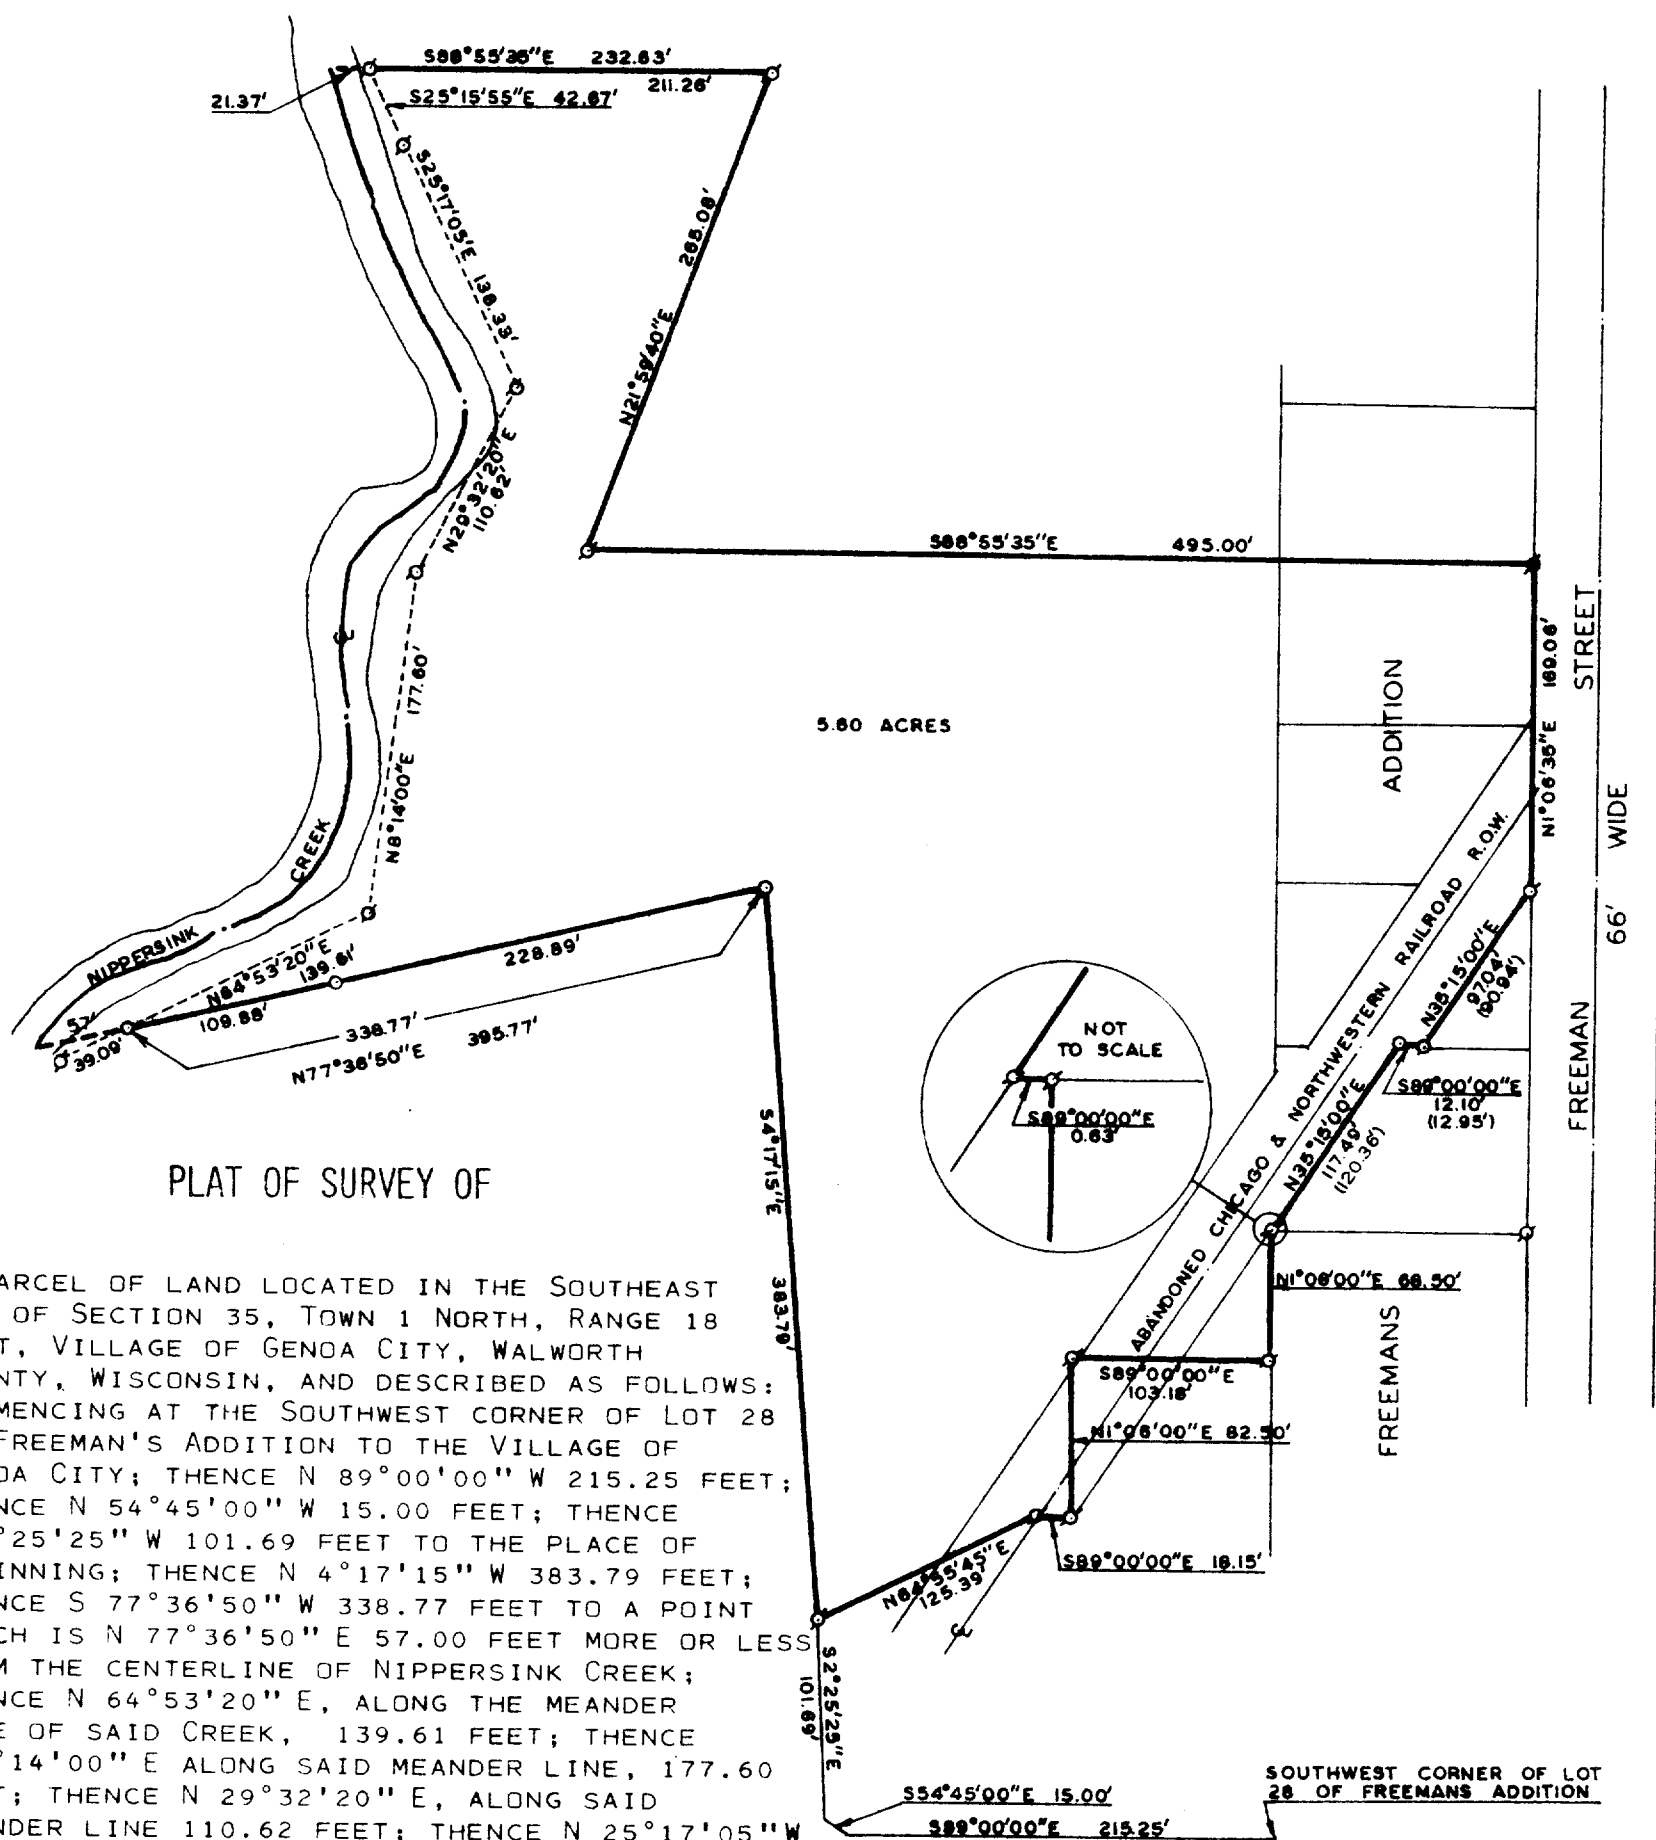

PLAT OF SURVEY OF

A PARCEL OF LAND LOCATED IN THE SOUTHEAST 1/4 OF SECTION 35, TOWN 1 NORTH, RANGE 18 EAST, VILLAGE OF GENOA CITY, WALWORTH COUNTY, WISCONSIN, AND DESCRIBED AS FOLLOWS: COMMENCING AT THE SOUTHWEST CORNER OF LOT 28 OF FREEMAN'S ADDITION TO THE VILLAGE OF GENOA CITY; THENCE N 89°00'00\" W 215.25 FEET; THENCE N 54°45'00\" W 15.00 FEET; THENCE N 2°25'25\" W 101.69 FEET TO THE PLACE OF BEGINNING; THENCE N 4°17'15\" W 383.79 FEET; THENCE S 77°36'50\" W 338.77 FEET TO A POINT WHICH IS N 77°36'50\" E 57.00 FEET MORE OR LESS FROM THE CENTERLINE OF NIPPERSINK CREEK; THENCE N 64°53'20\" E, ALONG THE MEANDER LINE OF SAID CREEK, 139.61 FEET; THENCE N 8°14'00\" E ALONG SAID MEANDER LINE, 177.60 FEET; THENCE N 29°32'20\" E, ALONG SAID MEANDER LINE 110.62 FEET; THENCE N 25°17'05\" W ALONG SAID MEANDER LINE, 138.33 FEET; THENCE N 25°15'55\" W, ALONG SAID MEANDER LINE, 42.67 FEET TO A POINT LOCATED S 88°55'35\" E 21.37 FEET FROM THE CENTERLINE OF SAID CREEK; THENCE S 88°55'35\" E 211.26 FEET; THENCE S 21°59'40\" W 265.08 FEET; THENCE S 88°55'35\" E 495.00 FEET; THENCE S 1°06'35\" W 169.06 FEET; THENCE S 35°15'00\" W 97.04 FEET; THENCE N 89°00'00\" W 12.10 FEET; THENCE S 35°15'00\" W 117.49 FEET; THENCE S 89°00'00\" E 0.63 FEET; THENCE S 1°06'00\" W 68.50 FEET; THENCE N 89°00'00\" W 103.18 FEET; THENCE S 1°06'00\" W 82.50 FEET; THENCE N 89°00'00\" W 18.15 FEET; THENCE S 64°55'45\" W 125.39 FEET TO THE PLACE OF BEGINNING, INCLUDING ALL LANDS LYING BETWEEN THE CENTERLINE OF SAID CREEK, AND SAID MEANDER LINE. CONTAINING 5.60 ACRES OF LAND MORE OR LESS.

ORDERED BY: H. CLARK
WISCONSIN DAIRIES COOP
407 FREEMAN STREET
GENOA CITY, WI 53128

FOR: J. HORAK

I, ROBERT M. BAERENWALD, DO HEREBY CERTIFY THAT I HAVE SURVEYED THE PROPERTY HEREON DESCRIBED ACCORDING TO THE OFFICIAL RECORDS, AND THAT THE PLAT HEREON IS A CORRECT REPRESENTATION OF THE LOT LINES TO THE BEST OF MY KNOWLEDGE AND BELIEF.

ROBERT M. BAERENWALD
WISCONSIN REGISTERED LAND SURVEYOR, S-1508
DATE



SCALE: 1\"=100'

o-IRON PIPE FOUND
o-IRON PIPE PLACED
() -RECORDED AS



TVGC-46G

6-132