
## PLATOF OFSURVEY

LOT 128, SECTION COUNTY, 25, TOWN 1 WISCONSIN. HUNTERS RIDGE SUBDIVISION, LOCATED IN THE 25, TOWN 1 NORTH, RANGE 18 EAST, VILLAGE ( OF GENOA CITY, WALWORTH CITÝ,

SURVEY SURVEY FOR: ADDRESS: KELLER WILLIAMS 263 DEER PATH DRIVE

NOTE: DOCUMENT NO. 380041 UTILITY AND STORM WATER EASEMENT DOES NOT AFFECT THIS PROPERTY. NOTE: DOCUMENT NO. 323367 WATER AND SANITARY SEWER EASEMENT DOES NOT AFFECT THIS PROPERTY.

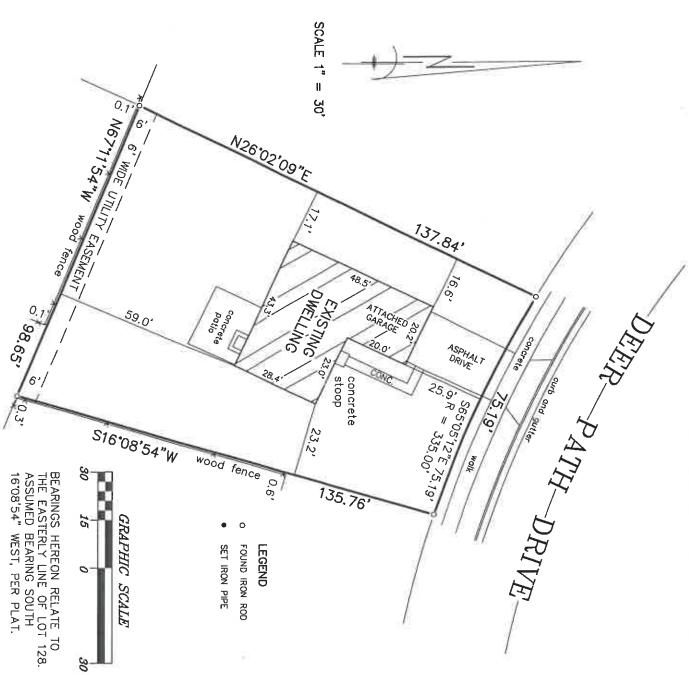

"I hereby certify that I have surveyed the above described property and that the above map is a correct representation thereof and shows the size and location of the property, its exterior boundaries, the location of all visible structures and dimensions of all principal buildings thereon, boundary fences, apparent easements, roadways and encroachments, if any."

"This survey is made for the use of the present owners of the property, and those who purchase, mortgage, or guarantee the title thereto within one year from date hereof."



BURLINGT

SCONS

ROBERT



B. **≪** SURVEYING, NC.

412 N. PINE STREET BURLINGTON, WI 53105 (262)-767-0225

DECEMBER 22, 2022

ROBERT J. WETZEL

S-1778 0

JOB NUMBER 10779

DATE