
KOLB LAND CONSULTING, INC.

LAND SURVEYING . SUBDIVIDING . LAND PLANNING

LAKE GENEVA, WISCONSIN 53147

MAIN STREET

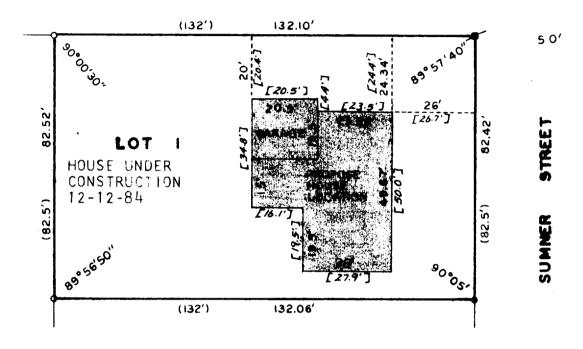


PLAT OF SURVEY OF


LOT 1 OF CAREYS ADDITION TO GENOA CITY, TIN, R18E, WALWORTH COUNTY, WISCONSIN.

ORDERED BY: ROBERT GIBSON

NOTE: WOOD STAKES SET AT ALL HOUSE CORNERS.

12-12-84 - RELOCATED PROPERTY CORNERS.
ORDERED BY: NORTH SHORE SAVINGS & LOAN MILWAUKEE, WI

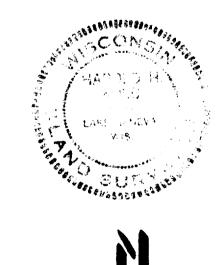

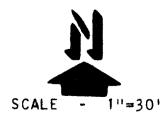

LEGEND

IRON PIPE SET

IRON BAR FOUND

RECORDED AS

MEASUREMENTS TAKEN
12-12-84

I HEREBY CERTIFY THAT I HAVE SURVEYED THE ABOVE DESCRIBED PROPERTY AND THAT THE ABOVE MAP IS A TRUE REPRESENTATION THEREOF AND SHOWS THE SIZE AND LOCATION OF THE PROPERTY, ITS EXTERIOR BOUNDARIES, THE LOCATION OF ALL VISIBLE STRUCTURES AND DIMENSIONS OF ALL PRINCIPAL BUILDINGS THEREON, BOUNDARY FENCES, APPARENT EASEMENTS, ROADWAYS AND VISIBLE ENCROACHMENTS, IF ANY.
THIS SURVEY IS MADE FOR THE USE OF THE PRESENT OWNERS OF THE PROPERTY, AND ALSO THOSE WHO PURCHASE, MORTGAGE, OR GUARANTEE THE TITLE THERETO WITHIN ONE (1) YEAR FROM DATE HEREOF.

HAROLD H. KOLB
WISCONSIN REGISTERED LAND SURVEYOR, S-187
DATE Oct. 9, 1984
REVISED: DEC. 12, 1984