


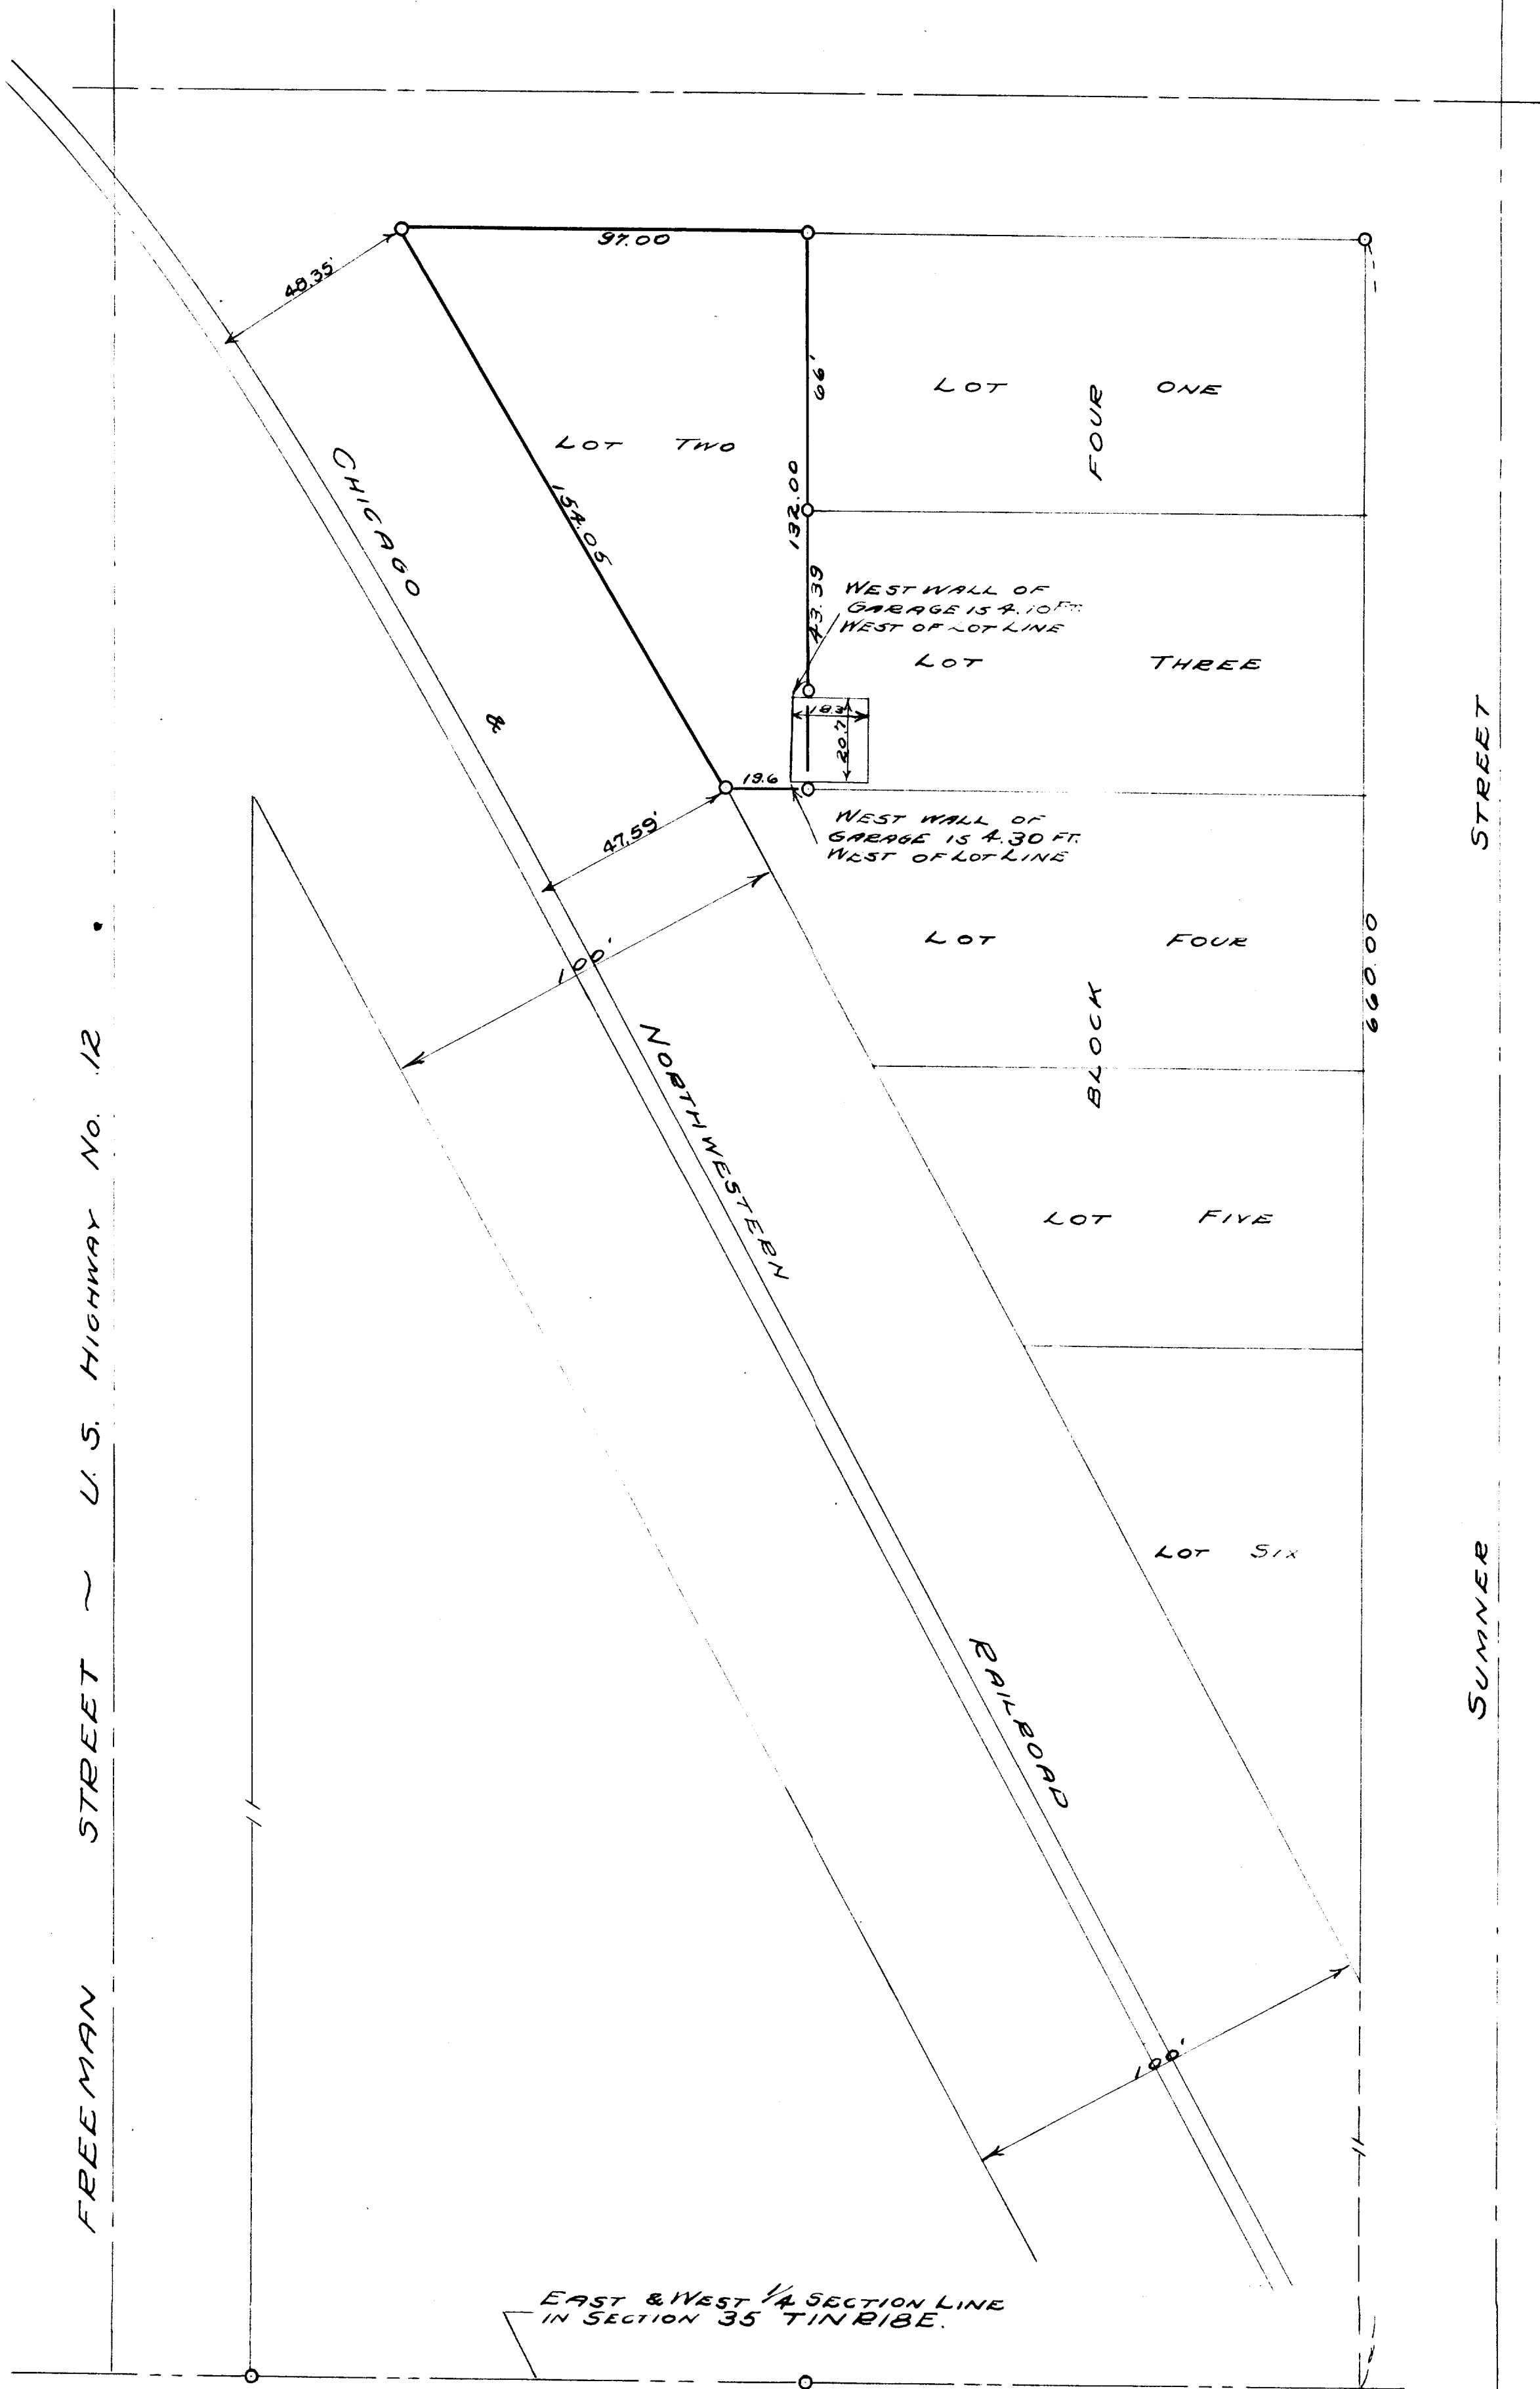

PLAT OF SURVEY OF LOT 2, BLOCK 4 OF
 J. H. ROWE'S ADDITION TO THE VILLAGE OF
 GENOA CITY, WALWORTH COUNTY, WISCONSIN.
 OCT. 6, 1939

Lloyd L. Jensen
 COUNTY SURVEYOR