



WALWORTH COUNTY  
SURVEYING & MAPPING  
LAKE GENEVA, WISCONSIN

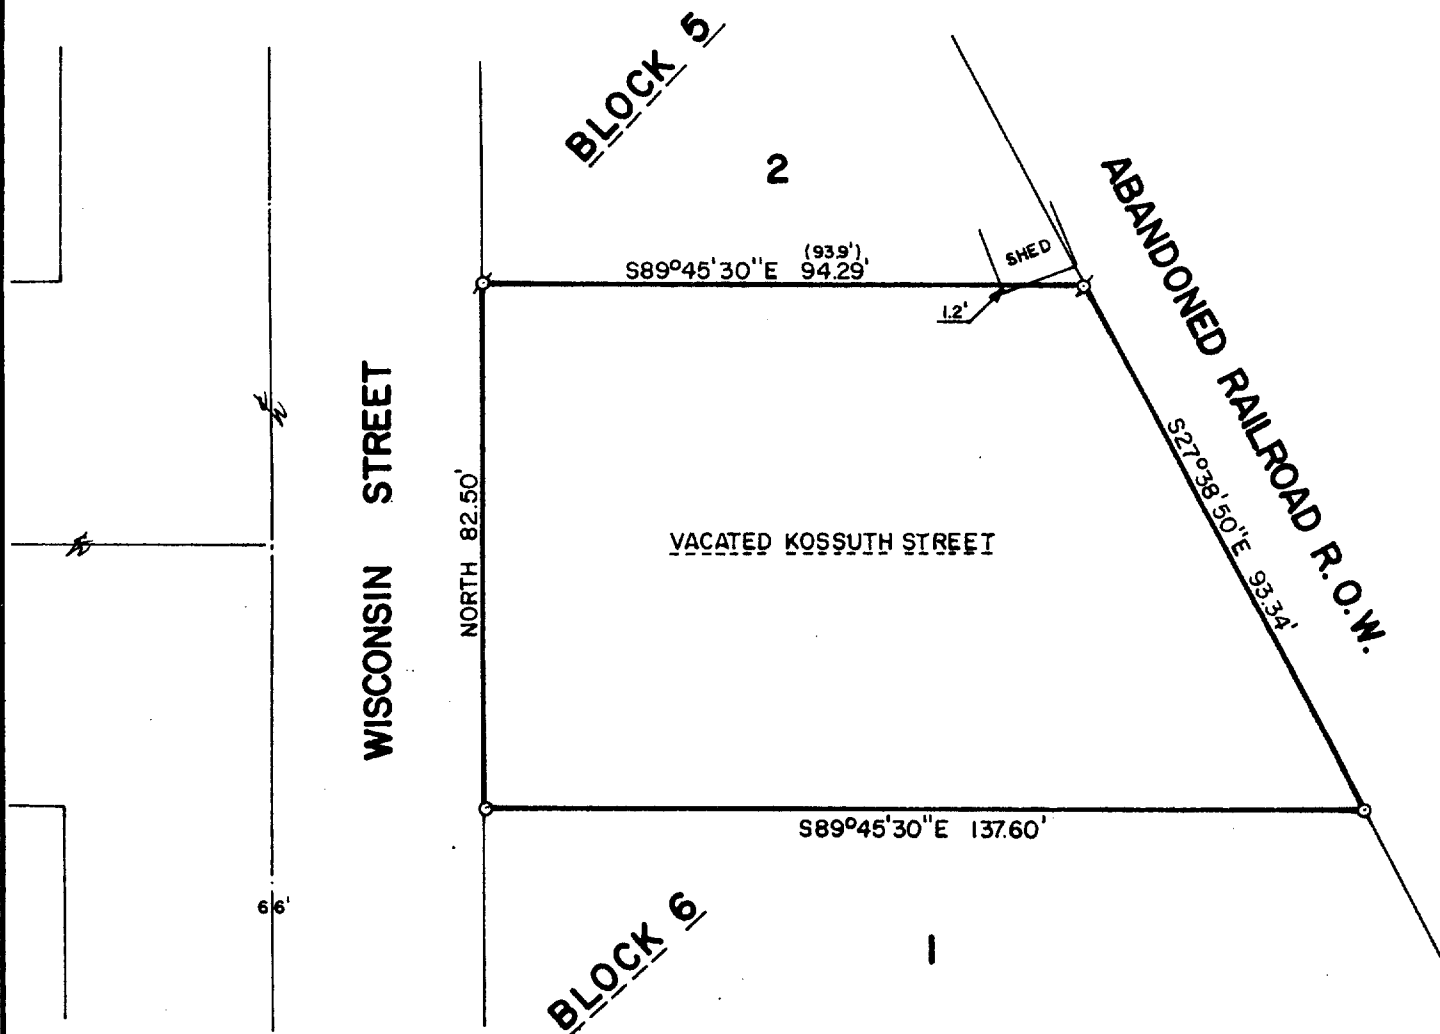

PLAT OF SURVEY OF

VACATED KOSSUTH STREET LOCATED IN FREEMAN'S SECOND ADDITION,  
A SUBDIVISION LOCATED IN THE SOUTHEAST 1/4 OF SECTION 35,  
T 1 N, R 18 E, VILLAGE OF GENOA CITY, WALWORTH COUNTY, WISCONSIN,  
DESCRIBED AS FOLLOWS: BEGINNING AT THE SOUTHWEST CORNER OF LOT  
2, BLOCK 5 OF SAID SUBDIVISION, THENCE S89°45'30"E 94.29 FEET TO  
THE SOUTHEAST CORNER OF SAID LOT 2, THENCE S27°38'50"E 93.34 FEET  
TO THE NORTHEAST CORNER OF LOT 1, BLOCK 6 OF SAID SUBDIVISION;  
THENCE N89°45'30"W 137.60 FEET TO THE NORTHWEST CORNER OF SAID  
LOT 1; THENCE NORTH 82.50 FEET TO THE PLACE OF BEGINNING.

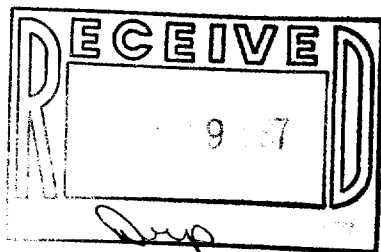

ORDERED BY: THE VILLAGE OF GENOA CITY



SCALE: 1"=30'

⊕ - IRON PIPE FOUND  
○ - IRON ROD PLACED  
( ) - RECORDED AS

I, ROBERT M. BAERENWALD, DO HEREBY CERTIFY THAT I  
HAVE SURVEYED THE PROPERTY HEREON DESCRIBED ACCORDING  
TO THE OFFICIAL RECORDS AND THAT THE PLAT HEREON IS A  
CORRECT REPRESENTATION OF THE PROPERTY LINES TO THE  
BEST OF MY KNOWLEDGE AND BELIEF.

*Robert M. Baerenwald*  
ROBERT M. BAERENWALD  
WISCONSIN REGISTERED LAND SURVEYOR, S-1508

*Aug 6, 1987*  
DATE JOB NO. 1120

NOTE: THIS IS NOT A CERTIFIED COPY UNLESS SEALED.