


PLAT OF SURVEY

OF

A PARCEL OF LAND LOCATED IN THE SOUTHEAST $\frac{1}{4}$ OF THE SOUTH-WEST $\frac{1}{4}$ OF SECTION 35, T1N R1E, VILLAGE OF GENOA CITY, WALWORTH COUNTY, WISCONSIN, DESCRIBED AS FOLLOWS, TO-WIT: COMMENCE AT THE SOUTH $\frac{1}{4}$ CORNER OF SAID SECTION 35; THENCE NORTH ALONG THE EAST LINE OF SAID $\frac{1}{4}$ SECTION, 966.66 FEET; THENCE N87°11'W 275.92 FEET; THENCE N67°30'W 317.29 FEET TO THE PLACE OF BEGINNING; THENCE SOUTH 200.00 FEET; THENCE N67°30'W 49.97 FEET; THENCE N73°58'W 107.39 FEET; THENCE N22°30'E 196.73 FEET; THENCE S67°30'E 80.00 FEET TO THE PLACE OF BEGINNING.

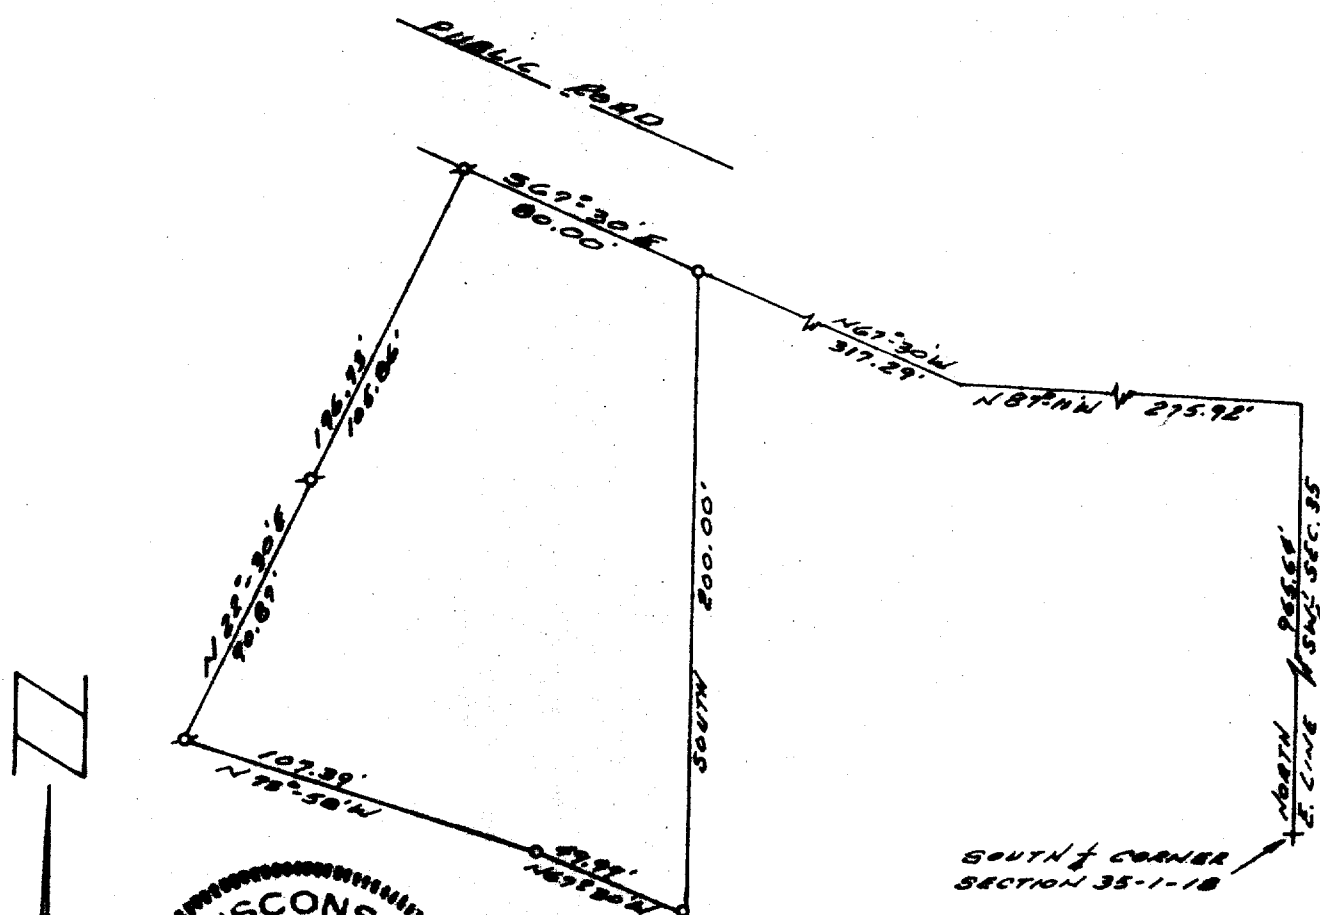

LEGEND

- — Iron Pipe FOUND
- — Concrete Monument
- Scale 1" = 60'
- 8" — IRON ROD SET

WE CERTIFY: That we have surveyed the above described property and that the plat shown hereon is an accurate survey and a true representation thereof and correctly shows the exterior boundary lines and all divisions of said property.

Date OCT 1980

Lloyd L. Jensen
LLOYD L. JENSEN,

Wisconsin Registered Land Surveyor, No. S-211