


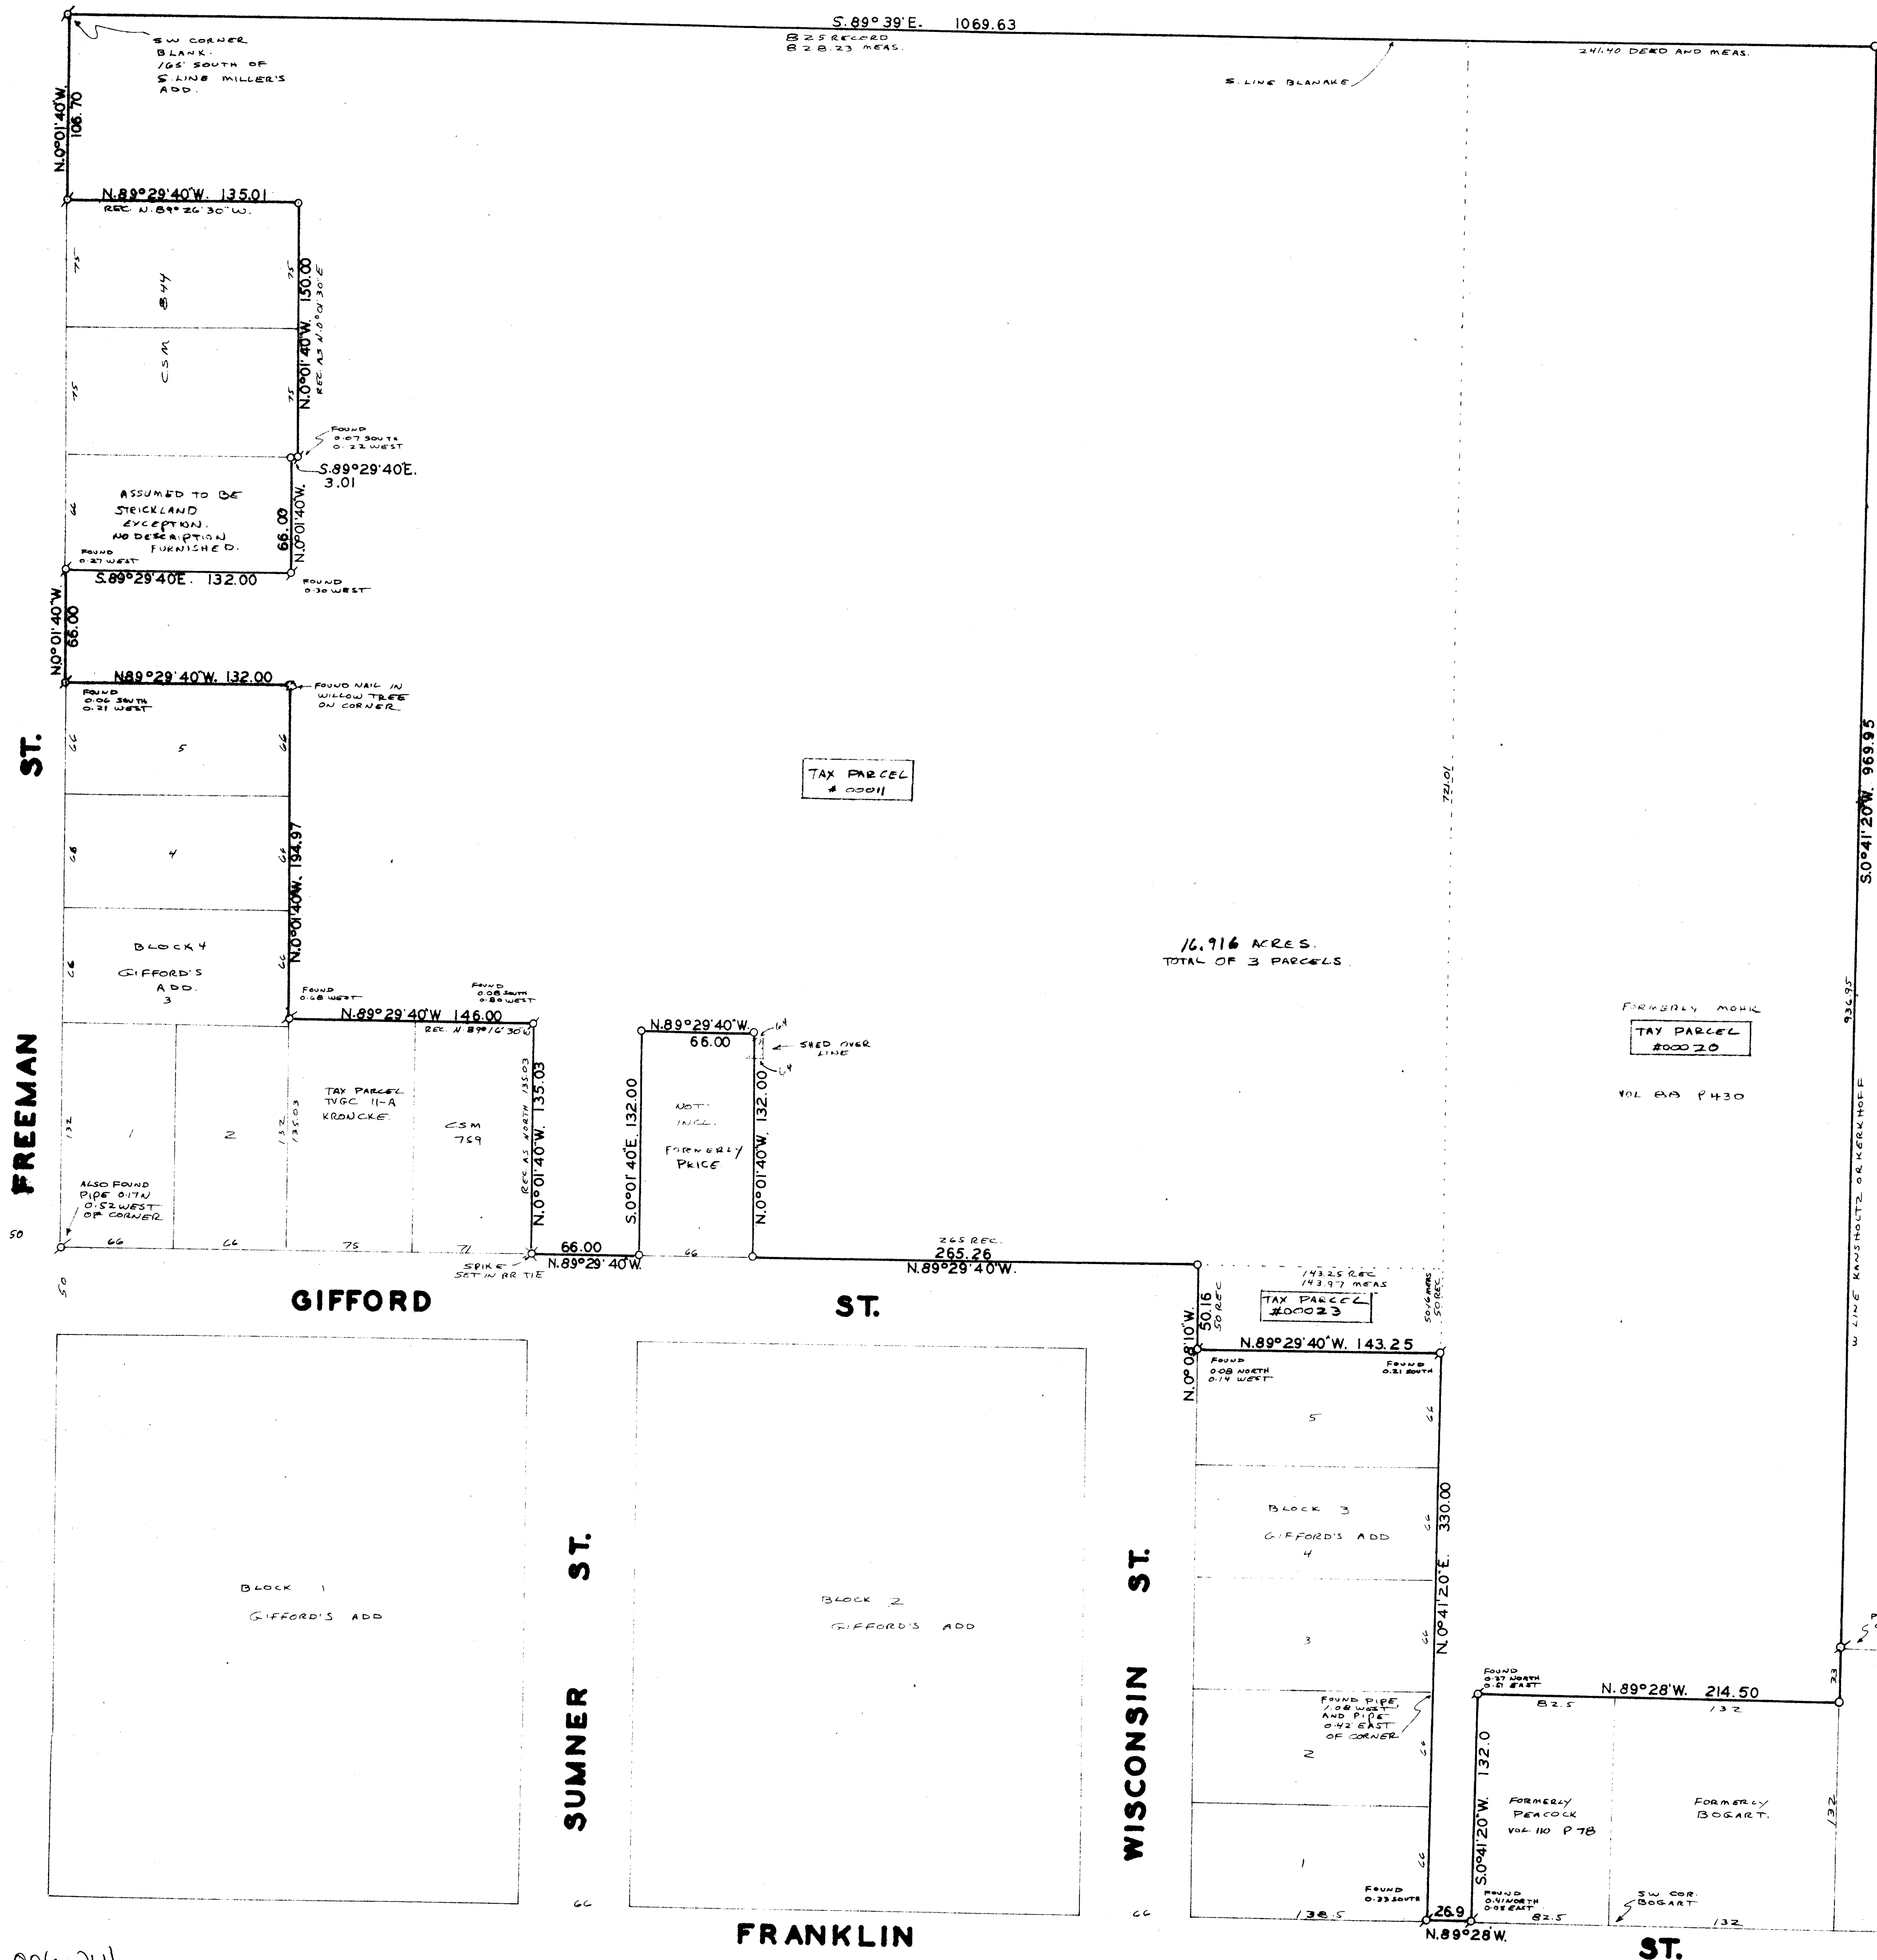


ANDRESEN

TITLE DESCRIPTION AS FURNISHED: A PART OF THE NE 1/4 OF SECTION 35 T1N, R18E, AND BOUNDED BY LINES AS FOLLOWS TO-WIT: BEGINNING AT THE SW CORNER OF LAND FORMERLY OWNED BY CHARLES BLANK, THENCE DIRECT EAST TO LAND FORMERLY OWNED BY THEO. MOHR, THENCE SOUTH TO A POINT IN LINE WITH THE NORTH SIDE OF GIFFORD'S ADDITION TO THE VILLAGE OF GENOA JUNC., WIS., THENCE NORTH ON THE EAST LINE OF MILL STREET TO THE PLACE OF BEGINNING, EXCEPT LOTS 1, 2, 3, 4 AND 5 AND TWO LOTS 4 X 8 RODS FORMERLY OWNED BY ED. G. PRICE AND ELMER STRICKLAND ALL OF WHICH IS SITUATED IN THE VILLAGE OF GENOA JUNCTION AND THE STATE OF WISCONSIN. LAND DESCRIBED IN VOLUME 88, PAGE 430 OF DEEDS, WALWORTH COUNTY RECORDS; ALSO PARCEL OF LAND 50 FEET WIDE BY 8 RODS LONG, ADJOINING ON WEST; ALSO ON NORTH OF LOT 5, BLOCK 3 GIFFORD'S ADDITION, VILLAGE OF GENOA CITY. EXCEPTING FURTHER LAND CONVEYED TO FRANK PEACOCK BY WARRANTY DEED RECORDED MARCH 5, 1901 ON VOLUME 110 OF DEEDS PAGE 78.

SCALE 1" EQUALS 50'
 X DENOTES IRON PIPE FOUND.
 O DENOTES IRON PIPE SET.

BEARINGS REFER TO SOUTH LINE OF BLANK (BLANK) WHICH IS THE NORTH LINE OF LANDS SURVEYED. SAID LINE USED AS S. 89° 39' E. TO ORIENT WITH OTHER SURVEYS IN AREA.

EXCEPTIONS FROM TITLE DESCRIPTION ABOVE:
 NO DESCRIPTIONS FURNISHED
 CSM 759
 CSM 844
 TAX PARCEL TVCC II-A - KRONCKE

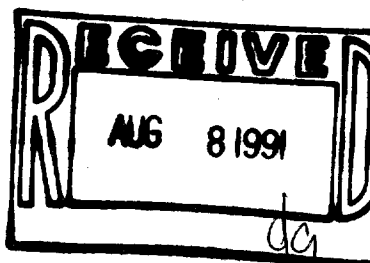

I have surveyed the above-described property, and the map herein is a true representation thereof and shows the size and location of the property, its exterior boundaries, the location and dimensions of all visible structures thereon, fences, apparent easements and roadways and visible encroachments, if any.

This survey is made for the exclusive use of the present owners of the property, and also those who purchase, mortgage, or guarantee the title thereto, within one year from date hereof.

Dated at Burlington, Wis., 24th day of JUNE 1991
 John F. Andersen
 John F. Andersen, Land Surveyor S 542
 509 N. Pine St. Burlington, WI 53205

TVCC 00011
 TVCC 00020