
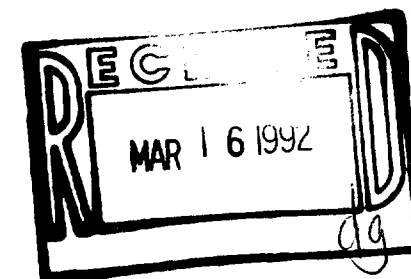


CENTURY SURVEYING
1544 W. MAIN STREET
LAKE GENEVA, WISC 53147
414-248-9423

PLAT OF SURVEY
OF
LOT 1 IN CERTIFIED SURVEY NO. 1808 RECORDED IN
VOLUME 8 CFPG 283 WCR IN THE NE $\frac{1}{4}$ OF THE SW $\frac{1}{4}$ OF
SECTION 35, TOWNSHIP 1 NORTH, RANGE 18 EAST
IN THE VILLAGE OF GENEVA CITY, WISCONSIN.

SCALE 1" = 20'

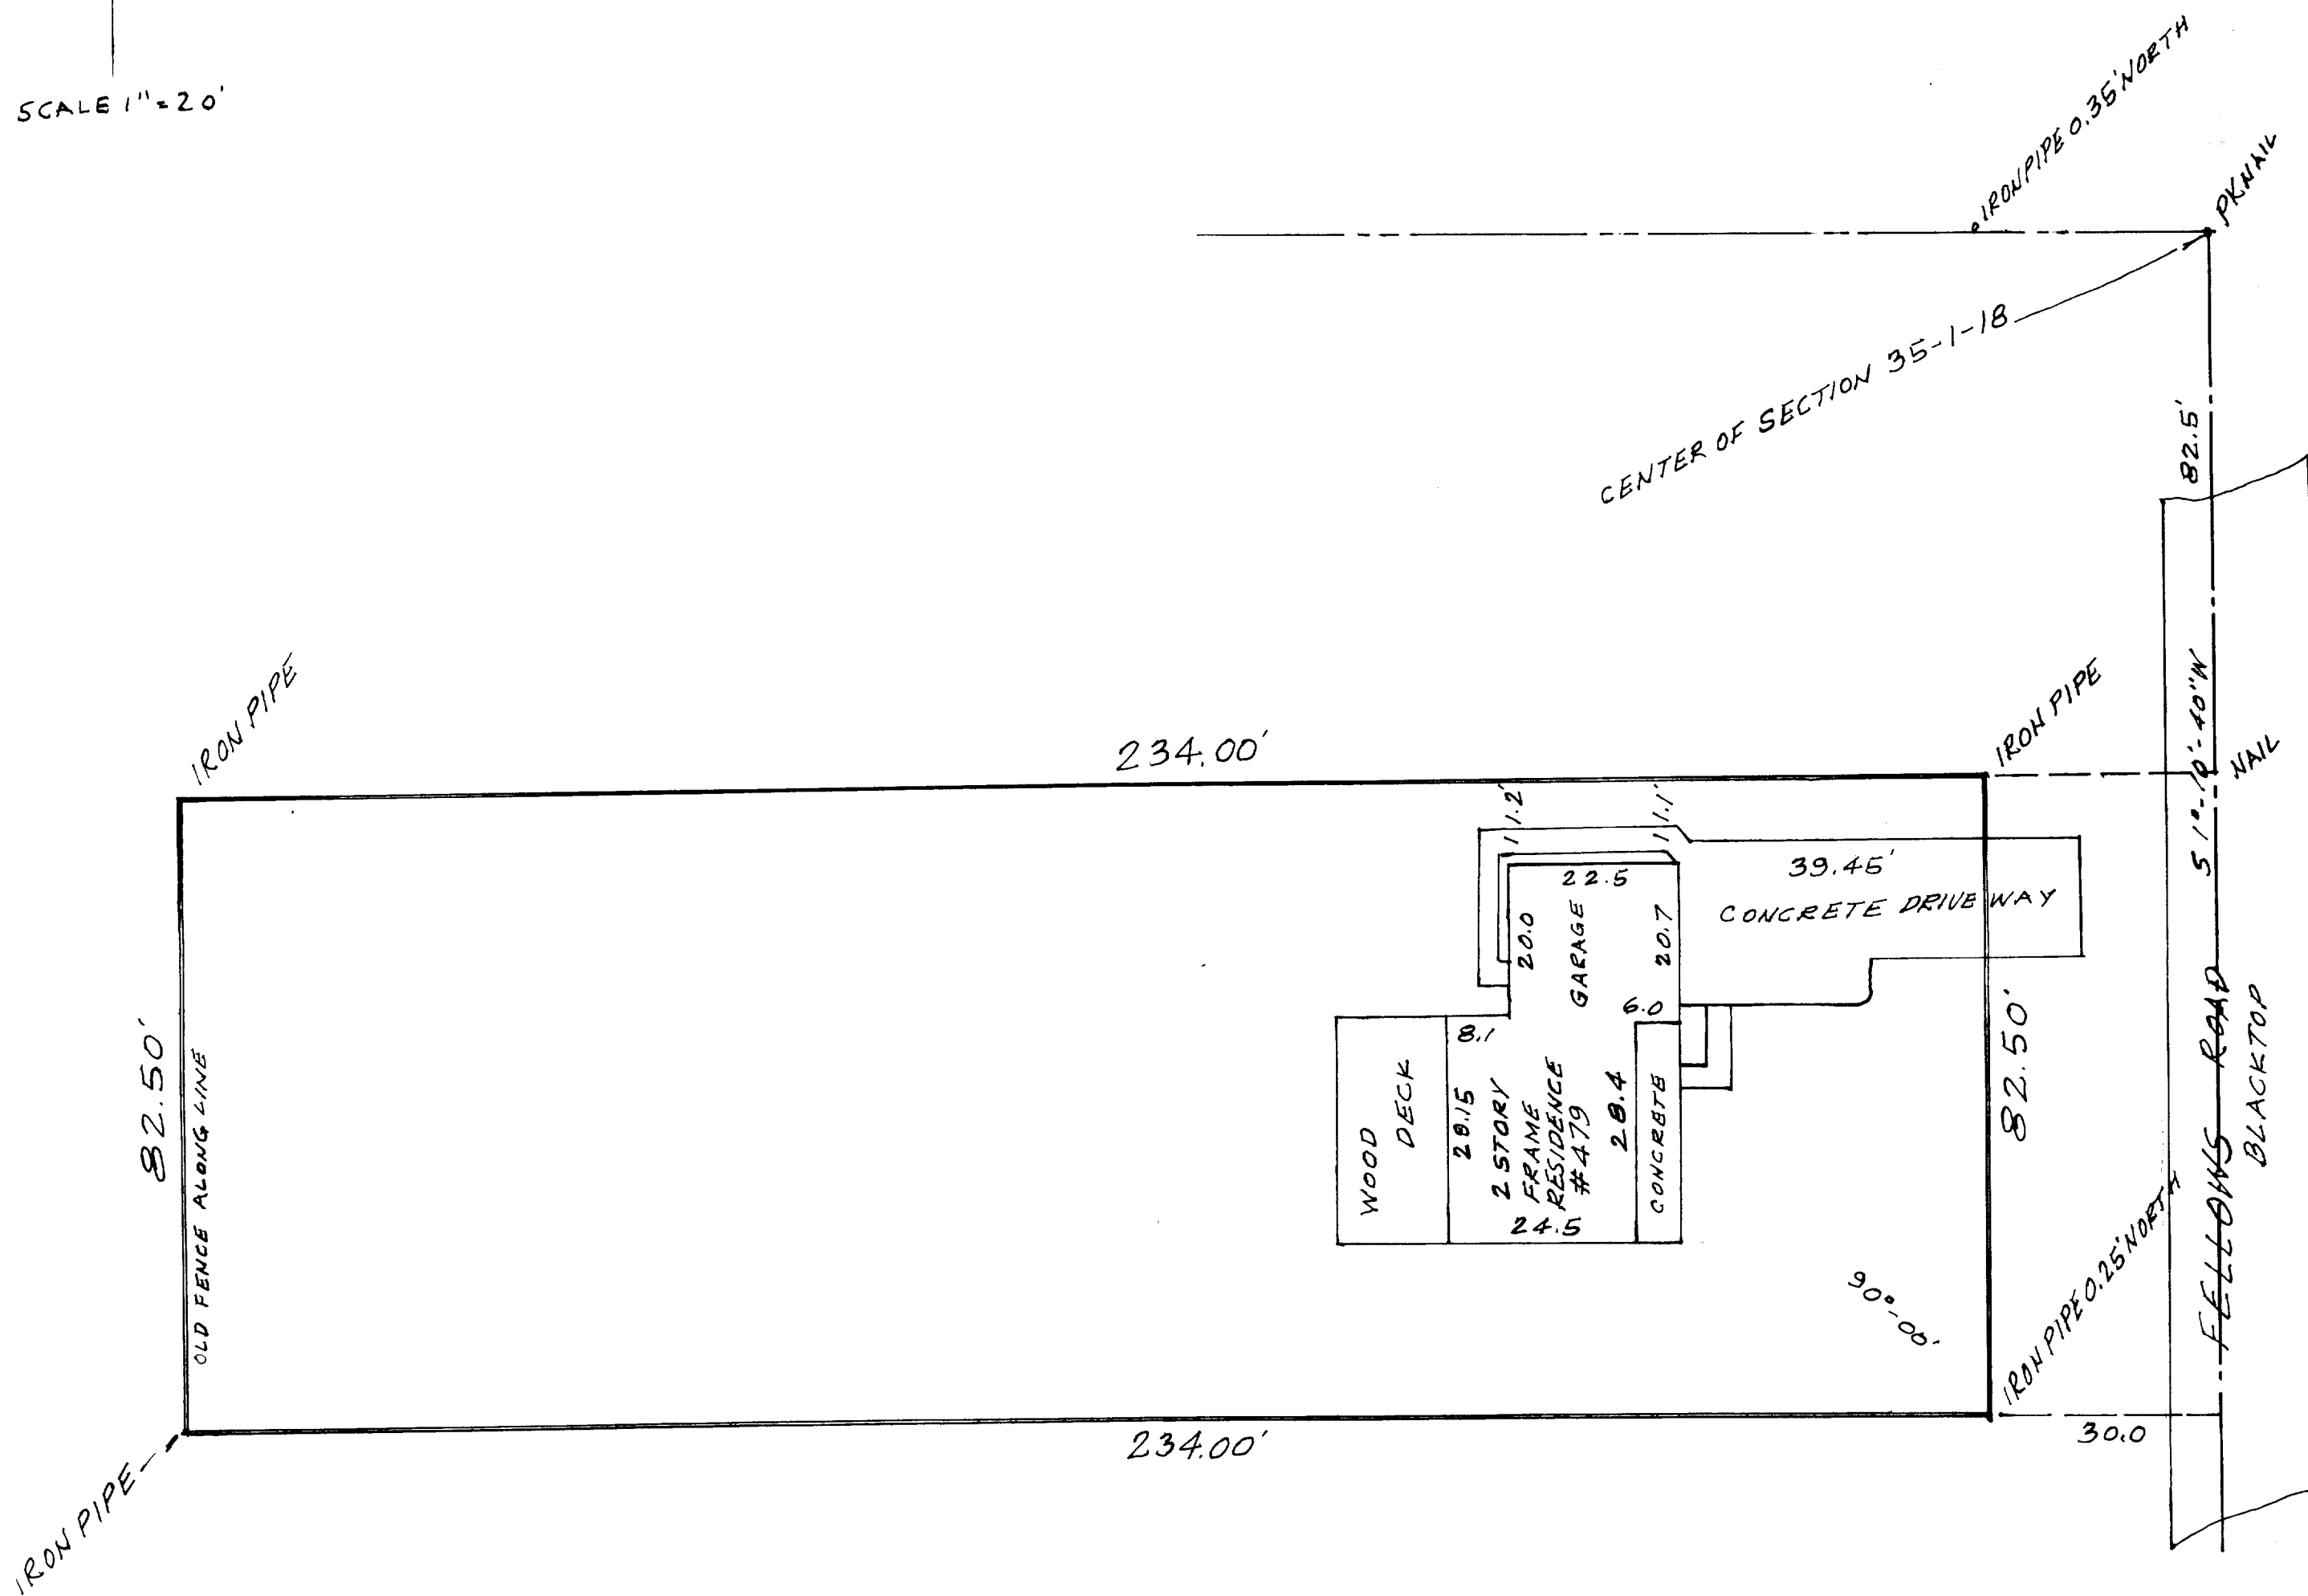

ORDER NO. 209

ORDERED BY: JOHN BORST
FIELD BOOK CES PAGE 49

ALL DIMENSIONS ARE GIVEN IN FEET AND
DECIMAL PARTS THEREOF AND ARE CORRECT
AT 68° FAHRENHEIT.

NOTE ANY DISCREPANCY IN MEASUREMENT
DISCOVERED UPON THE GROUND SHOULD
BE PROMPTLY REPORTED TO THE SURVEYOR
FOR EXPLANATION OR CORRECTION.

DATE FEBRUARY 2, 1992

STATE OF WISCONSIN)
WALWORTH COUNTY) SS

CHARLES E. SMITH HEREBY CERTIFIES
THAT HE HAS SURVEYED THE ABOVE
DESCRIBED PROPERTY AND THAT THE
PLAT HERON DRAWN IS A CORRECT
REPRESENTATION OF SAME.

Charles E. Smith
WISCONSIN REGISTERED
LAND SURVEYOR No. S1038