


FREEMAN

STREET

KOSSUTH

STREET

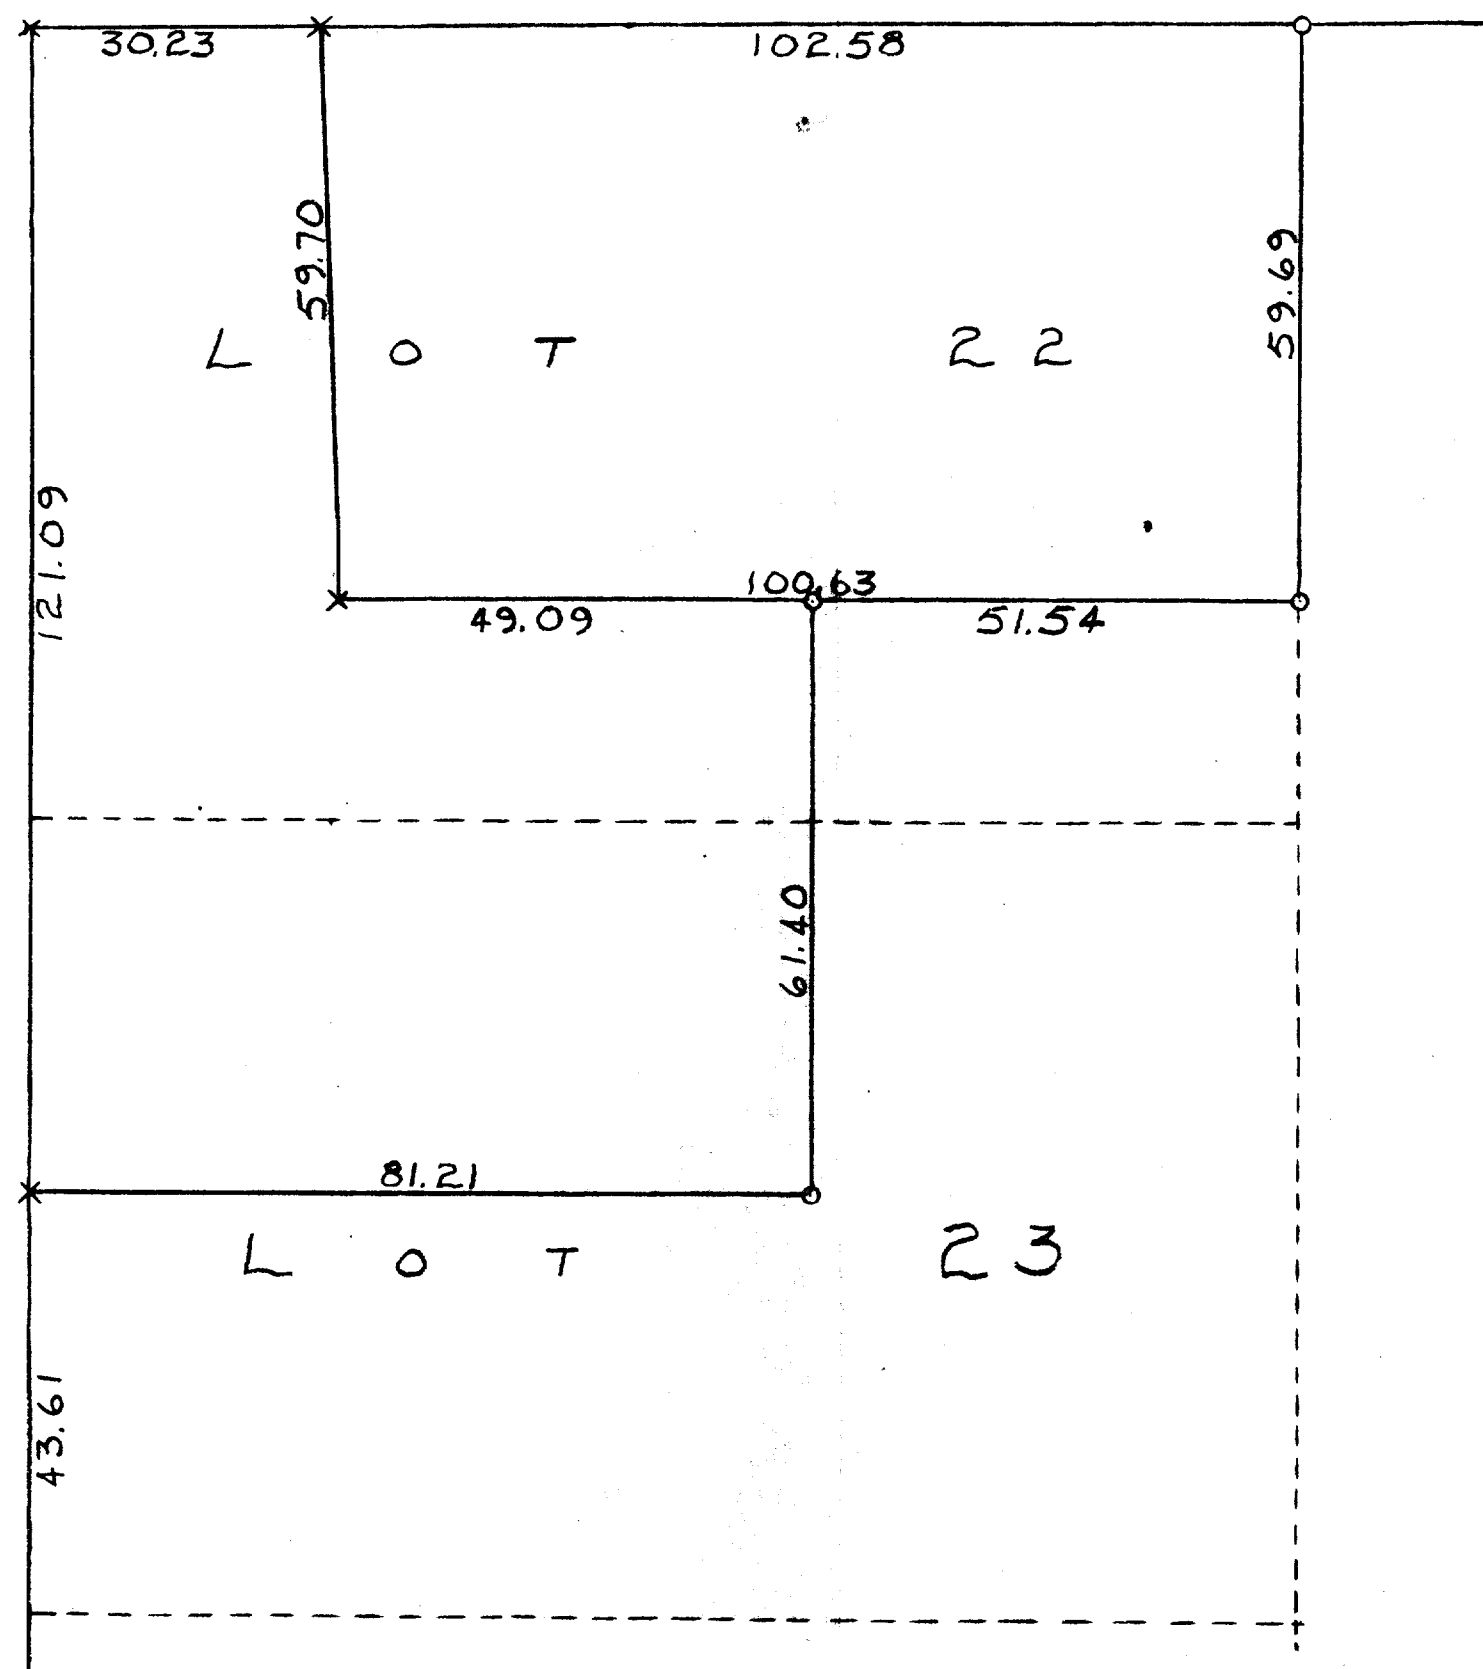

X CROSS IN CONC.  
IRON PIPE OR ROD  
SCALE - 1" = 20'

STATE OF WISCONSIN)  
COUNTY OF WALWORTH)

I, GEORGE T. DUNHAM, DO HEREBY CERTIFY THAT I HAVE SURVEYED A PART OF  
LOTS 22 AND 23 OF FREEMAN'S ADDITION TO GENOA JUNCTION (NOW GENOA CITY)  
WALWORTH COUNTY, WISCONSIN, AND THAT THE ABOVE PLAT IS A CORRECT  
REPRESENTATION OF SUCH SURVEY.  
MARCH 13, 1957

George T. Dunham  
GEORGE T. DUNHAM,  
DELAVER, WISCONSIN  
WIS. LAND SURVEYOR No. S-306