


DESCRIPTION: Commencing at the $\frac{1}{4}$ corner of Section 35 T. 1 N., R 18 E. Walworth County, Wisconsin; thence S. $89^{\circ} 58'$ W. along the south line of said section 244.63 feet to a concrete monument in the west line of a public road, the place of beginning of the lands hereinafter described: thence continue S. $89^{\circ} 58'$ W. along the south line of said section 167.00 feet, thence N. $34^{\circ} 04'$ E 120.76 feet, thence N. $89^{\circ} 58'$ E. 167.00 feet to an iron pipe in the west line of said road, thence S. $34^{\circ} 04'$ W. along the west line of said road 120.76 feet to the place of beginning.

CERTIFICATE: I, James F. Biagi, surveyor, do hereby certify that I have surveyed the property hereon described and that the location of the improvements are as shown.

OCTOBER 28, 1964.

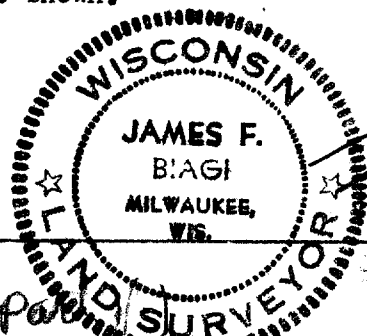

James F. Biagi, RLS 272