



PLAT OF SURVEY OF

Commencing (beginning) 244.88 feet West of point on the east line of Section 35, Township 1 North, Range 18 East of the 4th Principal Meridian, 1092.31 feet South of the east quarter section corner, South 200 feet to a stake 33 feet North of the centerline of Highway 12 (County Trunk Highway "H"), West 115 feet to a stake 50 feet northeasterly from the centerline of the Chicago and Northwestern Railroad tracks and 33 feet North of the center line of the highway, North 28 degrees West 226.70 feet to a stake 50 feet northeasterly from center line above described railroad tracks, East 221.16 feet to a stake at the point of beginning in Section 35, Township 1 North Range 18 East, in Walworth County, Wisconsin.

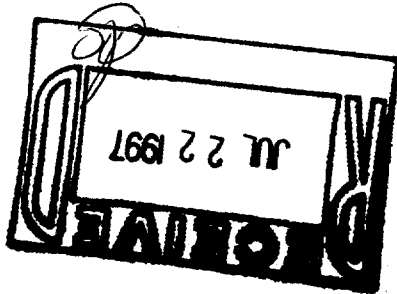

E 1/4 CORNER OF
SEC. 35 - T. 1N - R. 18E

V. C. A. I. C. A.
DEED = 1000.00' MEAS. = 1000.00'

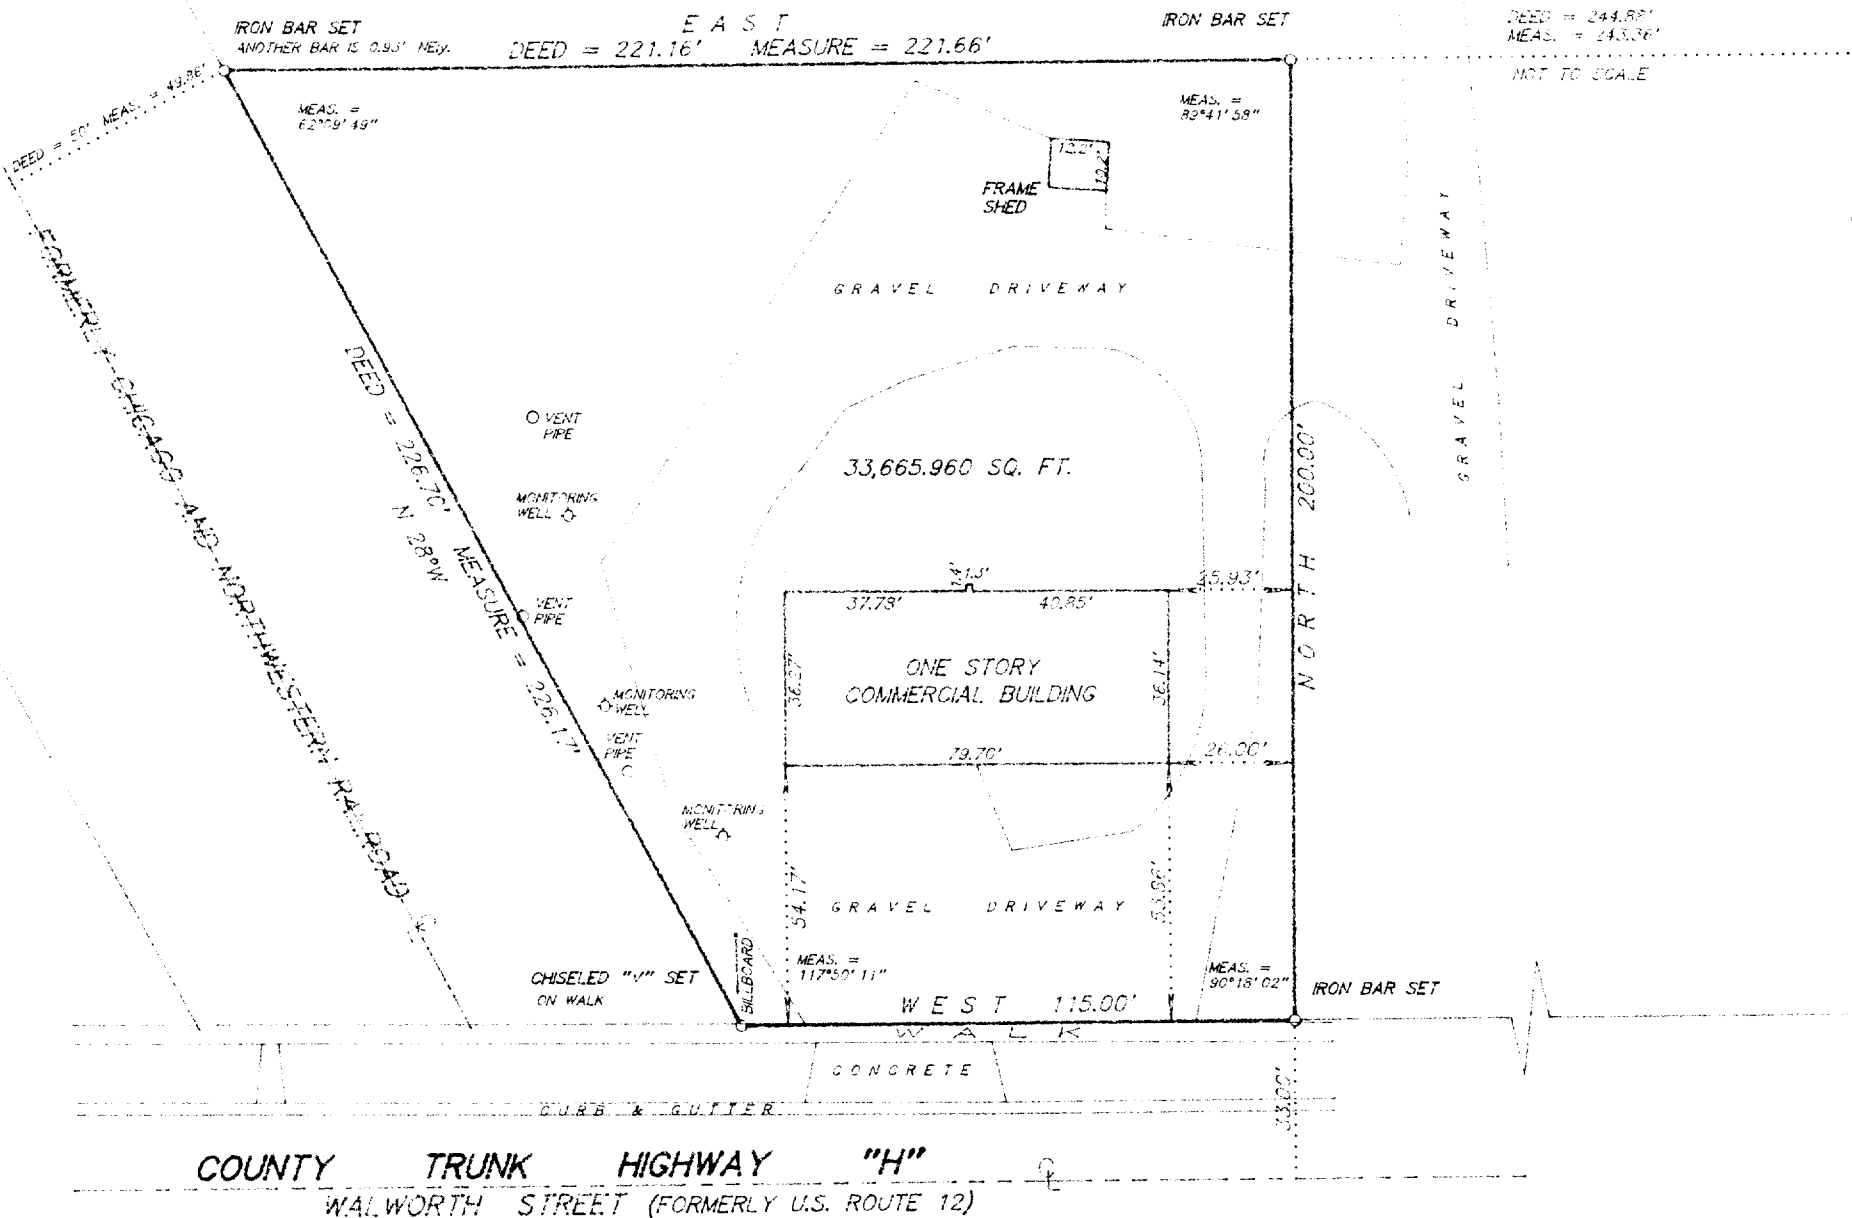

SCALE 1 inch = 40 feet

ORDERED BY R. DeMartini / Santar & DeMartini, LTD

JOB NO. 96386

I hereby certify that I have surveyed the above described property and the above plat is a true representation thereof and shows the size and location of the property, its exterior boundaries, the location and dimensions of all visible structures thereon, boundary fences, apparent easements and roadways and visible encroachments, if any.

This survey is made for the exclusive use of the present owners of the property, and also those who purchase, mortgage, or guarantee the title thereto within one year from the date hereof.

Dated at Bassett, Wisconsin this 1 day of July, 1997.

Mark A. Bolender
Wisconsin Registered Land Surveyor S - 1784

TUGG-43A
006-546