

FARRIS, HANSEN & ASSOCIATES, INC.


ENGINEERING, ARCHITECTURE, SURVEYING
7 RIDGEWAY COURT - P.O. BOX 437, ELKHORN, WISCONSIN, 53121

PHONE: (414) 723-2098 FAX: (414) 723-5886

PLAT OF SURVEY

LOT 19 OF HUNTERS RIDGE SUBDIVISION




LOCATED IN ALL 1/4'S OF THE SW 1/4
SECTION 25, TOWN 1 NORTH, RANGE 18 EAST
VILLAGE OF GENOA CITY, WALWORTH COUNTY, WISCONSIN

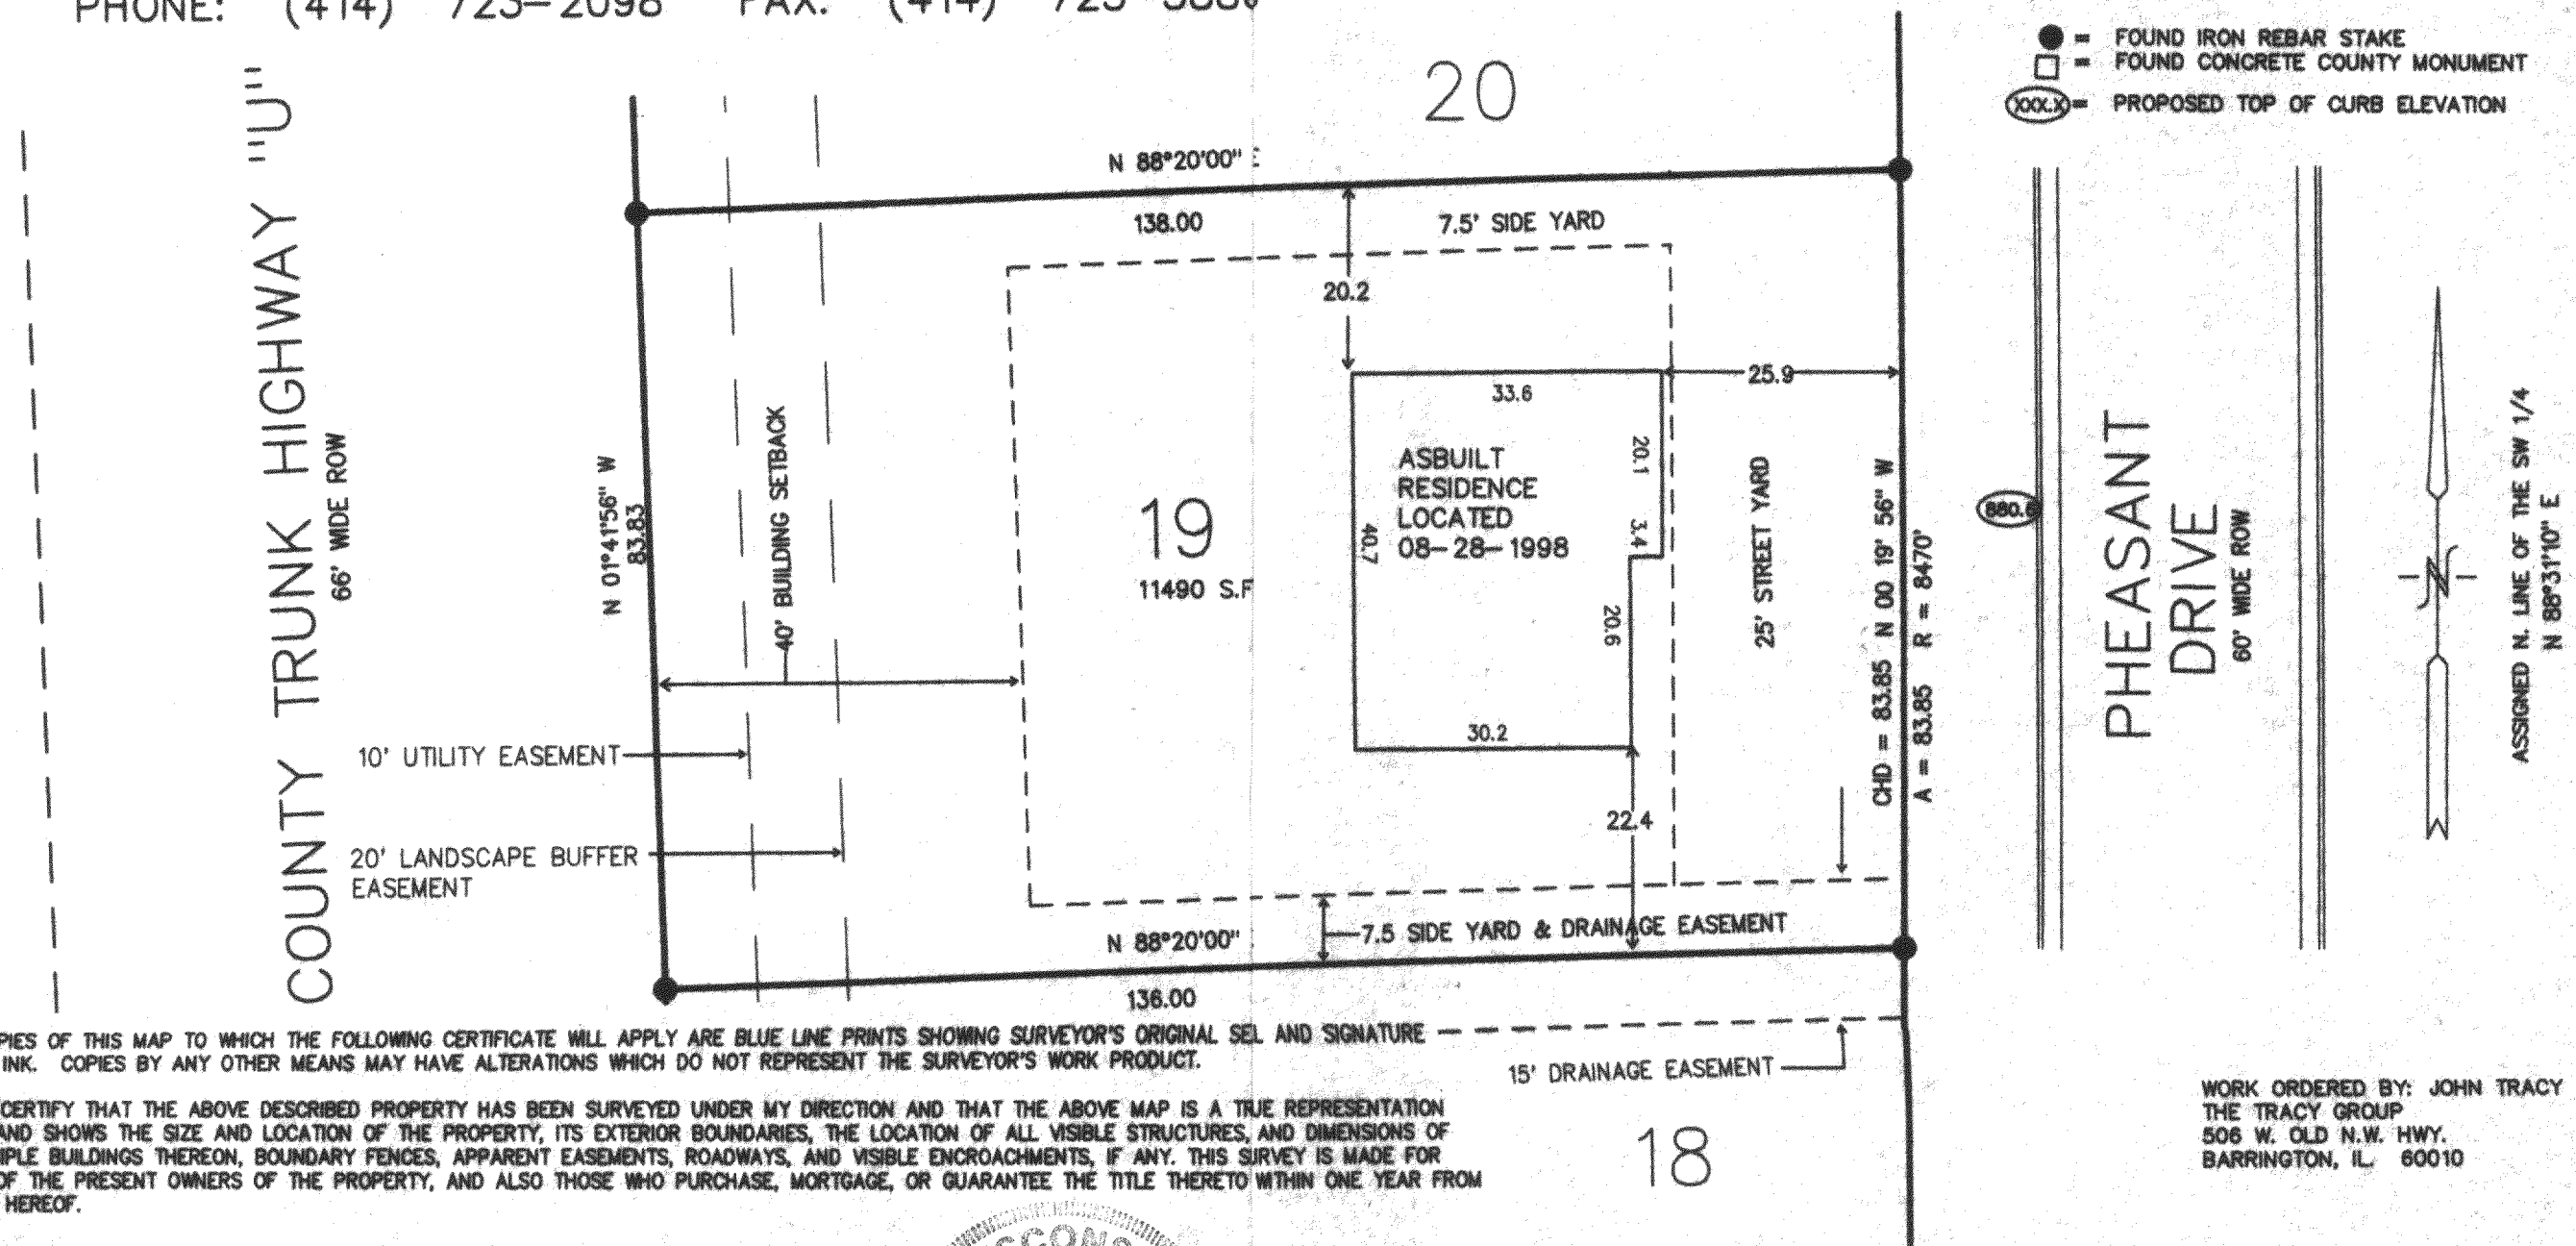

DATED: 06-02-1998

REVISED 08-28-1998 TO SHOW SIZE & LOCATION OF ASBUILT RES.

Peter S. Gordon
PETER S. GORDON R.L.S. 2101

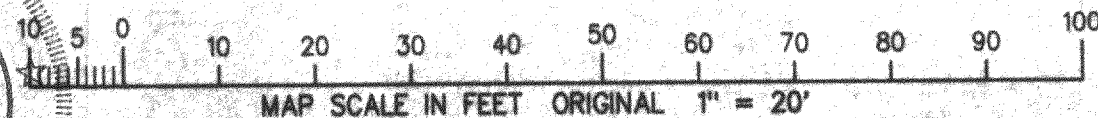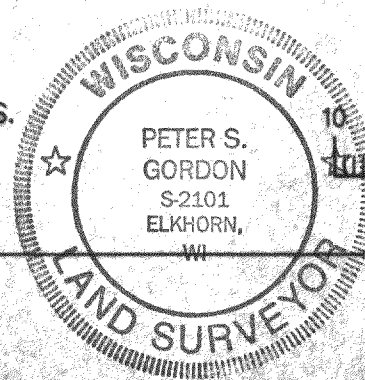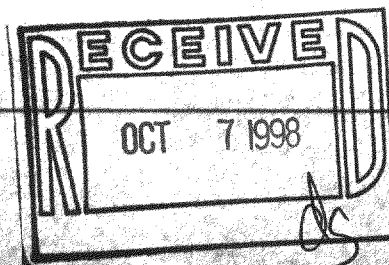

PROJECT 4267.19

SHEET 1 OF 1

THR-19
006-548