

PLAT OF SURVEY

OF


A PARCEL OF LAND LOCATED IN
THE NE¹/₄ OF SECTION 35, T1N
R18E, VILLAGE OF GLENDA
CITY, WALWORTH COUNTY, WIS.

"OLD" CEMETARY
SOUTH LINE

PL BEING THE S.E. COR. OF
PARCEL OF LAND = LIDELL
TO RASCH Vol. BB P. 421

CERTIFIED
SURVEY #178

RECORD
N 89° 39' W 206.25'

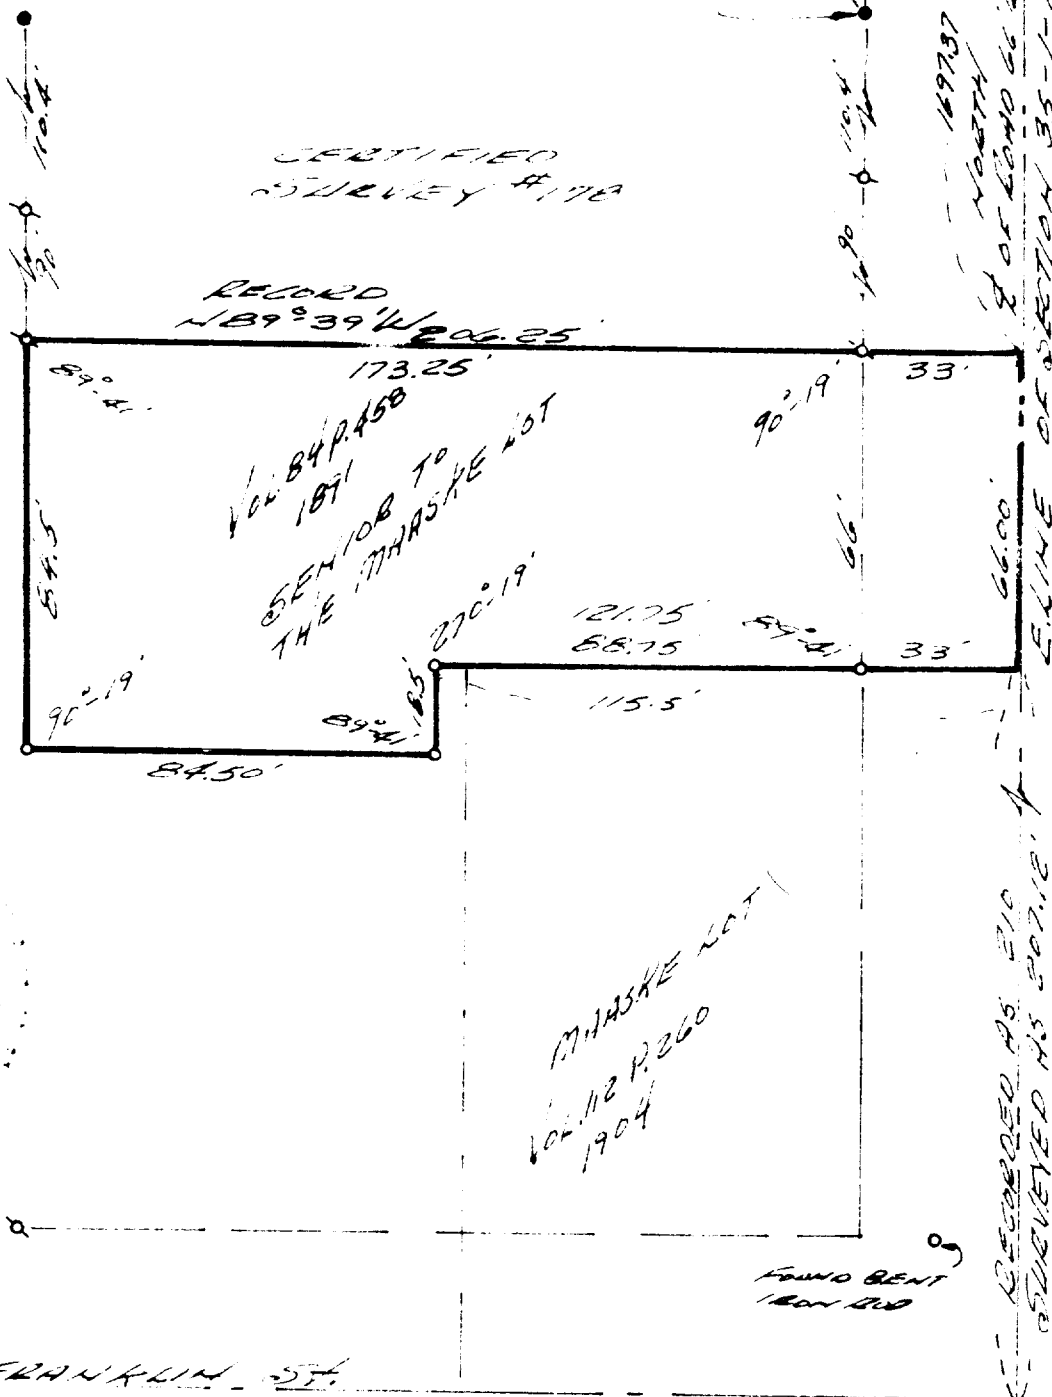

OWNER: L. OGDON
Vol. 423 P. 493

SURVEY AND PLAT BY
JENSEN & JOHNSON, INC.
CIVIL ENGINEERS AND SURVEYORS

Elkhorn, Wisconsin

LEGEND

- — Iron Pipe SET
- — Concrete Monument FOUND
- Scale 1" = 40'
- δ — 120N PIPE FOUND

WE CERTIFY: That we have surveyed the above described property and that the plat shown hereon is an accurate survey and a true representation thereof and correctly shows the exterior boundary lines and all divisions of said property.

Date MAY 22, 1975

Thomas P. Jensen

Wisconsin Registered Land Surveyor, No. S-1004