

# DEGEN, FOAT SURVEYING ASSOCIATES


100 SOUTH SECOND STREET  
WATERFORD, WISCONSIN  
(414)534-5404 (FAX)534-2022

993056  
993056S1.DWG

## PLAT OF SURVEY

LOT 20, ORIGINAL PLAT OF GENOA NOW THE VILLAGE OF GENOA CITY, BEING A PART OF THE WEST HALF OF THE SOUTHEAST 1/4 OF SECTION 35, TOWN 1 NORTH, RANGE 18 EAST, VILLAGE OF GENOA CITY, WALWORTH COUNTY, WISCONSIN.


SURVEY PREPARED FOR: CENTURY 21 ZENK REALTY, LLC.  
100 ELIZABETH LANE  
GENOA CITY, WI 53121

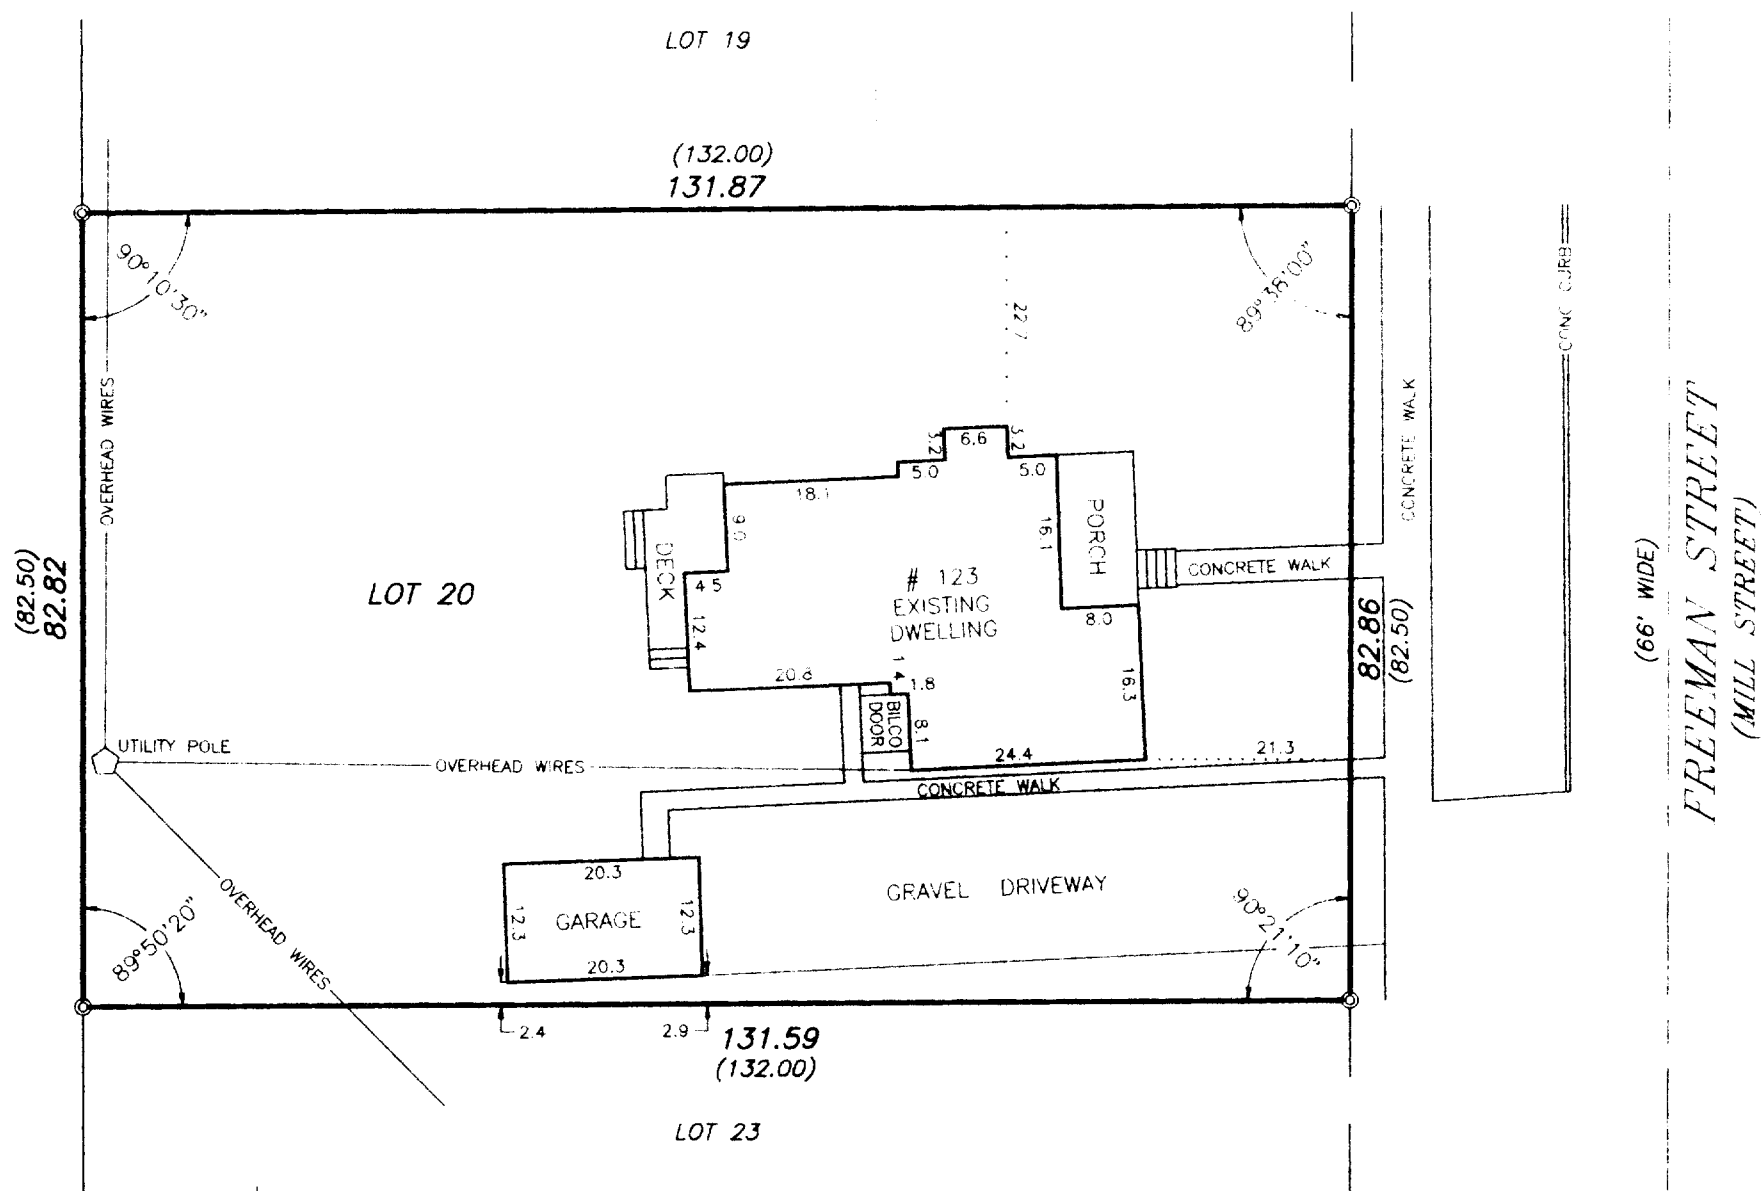

SCALE: 1" = 20'

### LEGEND

( ) - RECORDED AS  
© - FOUND IRON PIPE

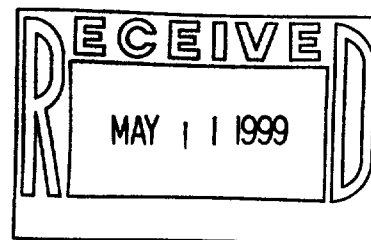

I HEREBY CERTIFY THAT I HAVE SURVEYED THE ABOVE DESCRIBED PROPERTY AND THE ABOVE MAP IS A TRUE REPRESENTATION THEREOF AND SHOWS THE SIZE AND LOCATION OF THE PROPERTY, THE LOCATION OF ALL VISIBLE STRUCTURES AND DIMENSIONS OF ALL PRINCIPAL BUILDINGS THEREON, BOUNDARY FENCES, APPARENT EASEMENTS, ROADWAY AND VISIBLE ENCROACHMENTS, IF ANY.

THIS SURVEY IS MADE FOR THE PRESENT OWNERS OF THE PROPERTY, AND ALSO THOSE WHO PURCHASE OR GUARANTEE THE TITLE THERETO WITHIN (1) YEAR FROM THE DATE HEREOF.

DATED AT WATERFORD, WI THIS 18th DAY OF MARCH 1999

RECEIVED

*Gary B. Foat*

TOP-31

006-628