FARRIS, HANSEN & ASSOCIATES, INC.

ENGINEERING, ARCHITECTURE, SURVEYING 7 RIDGEWAY COURT - P.O. BOX 437, ELKHORN, WISCONSIN, 53121

PLAT OF SURVEY


LOT 197 OF HUNTERS RIDGE SUBDIVISION

LINE OF 1

żz

506 W. OLD N.W. HWY. BARRINGTON, IL. 60010

LOCATED IN ALL 1/4'S OF THE SW 1/4 SECTION 25, TOWN 1 NORTH, RANGE 18 EAST VILLAGE OF GENOA CITY, WALWORTH COUNTY, WISCONSIN

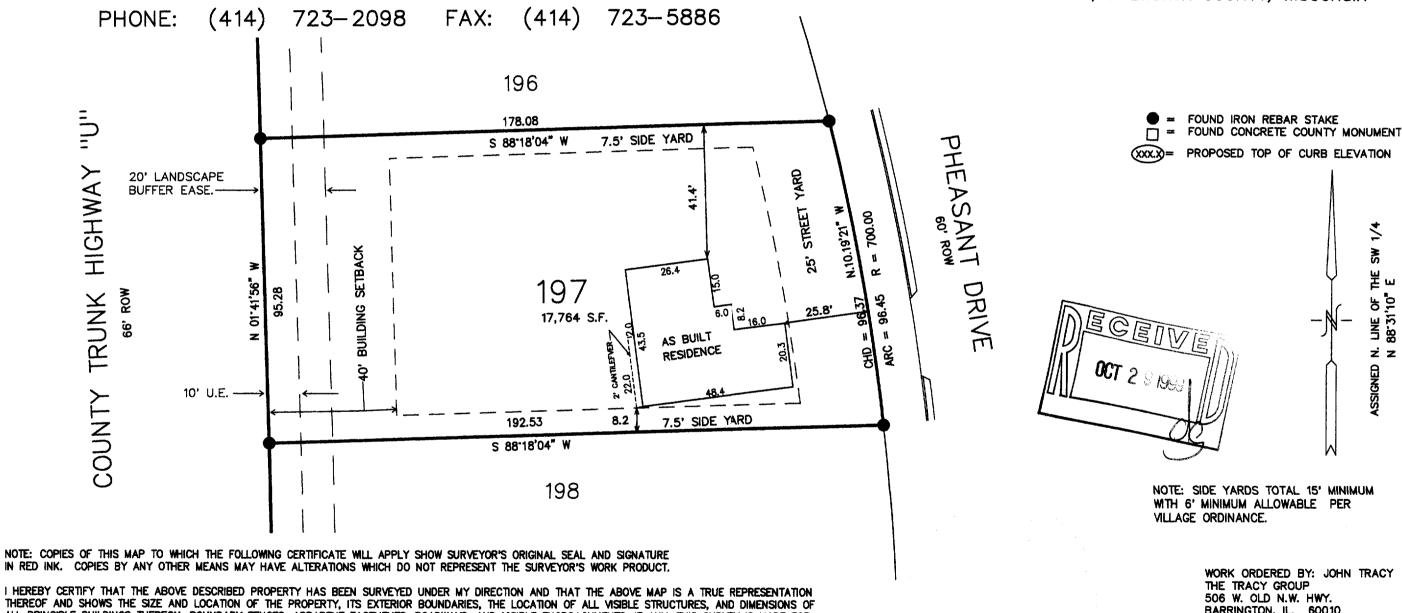

DATED: 07-12-99

THE DATE HEREOF.

REVISED 10-07-99 TO SHOW SIZE & LOCATION OF RESIDENCE AS BUILT

ALL PRINCIPLE BUILDINGS THEREON, BOUNDARY FENCES, APPARENT EASEMENTS, ROADWAYS, AND VISIBLE ENCROACHMENTS, IF ANY. THIS SURVEY IS MADE FOR THE USE OF THE PRESENT OWNERS OF THE PROPERTY, AND ALSO THOSE WHO PURCHASE, MORTGAGE, OR GUARANTEE THE TITLE THERETO WITHIN ONE YEAR FROM

PETER S. GORDON R.L.S. 2101

10 5 0 PROJECT 4267.197 SHEET 1 OF 1 MAP SCALE IN FEET ORIGINAL 1" = 30'

00le-675 THR-197