


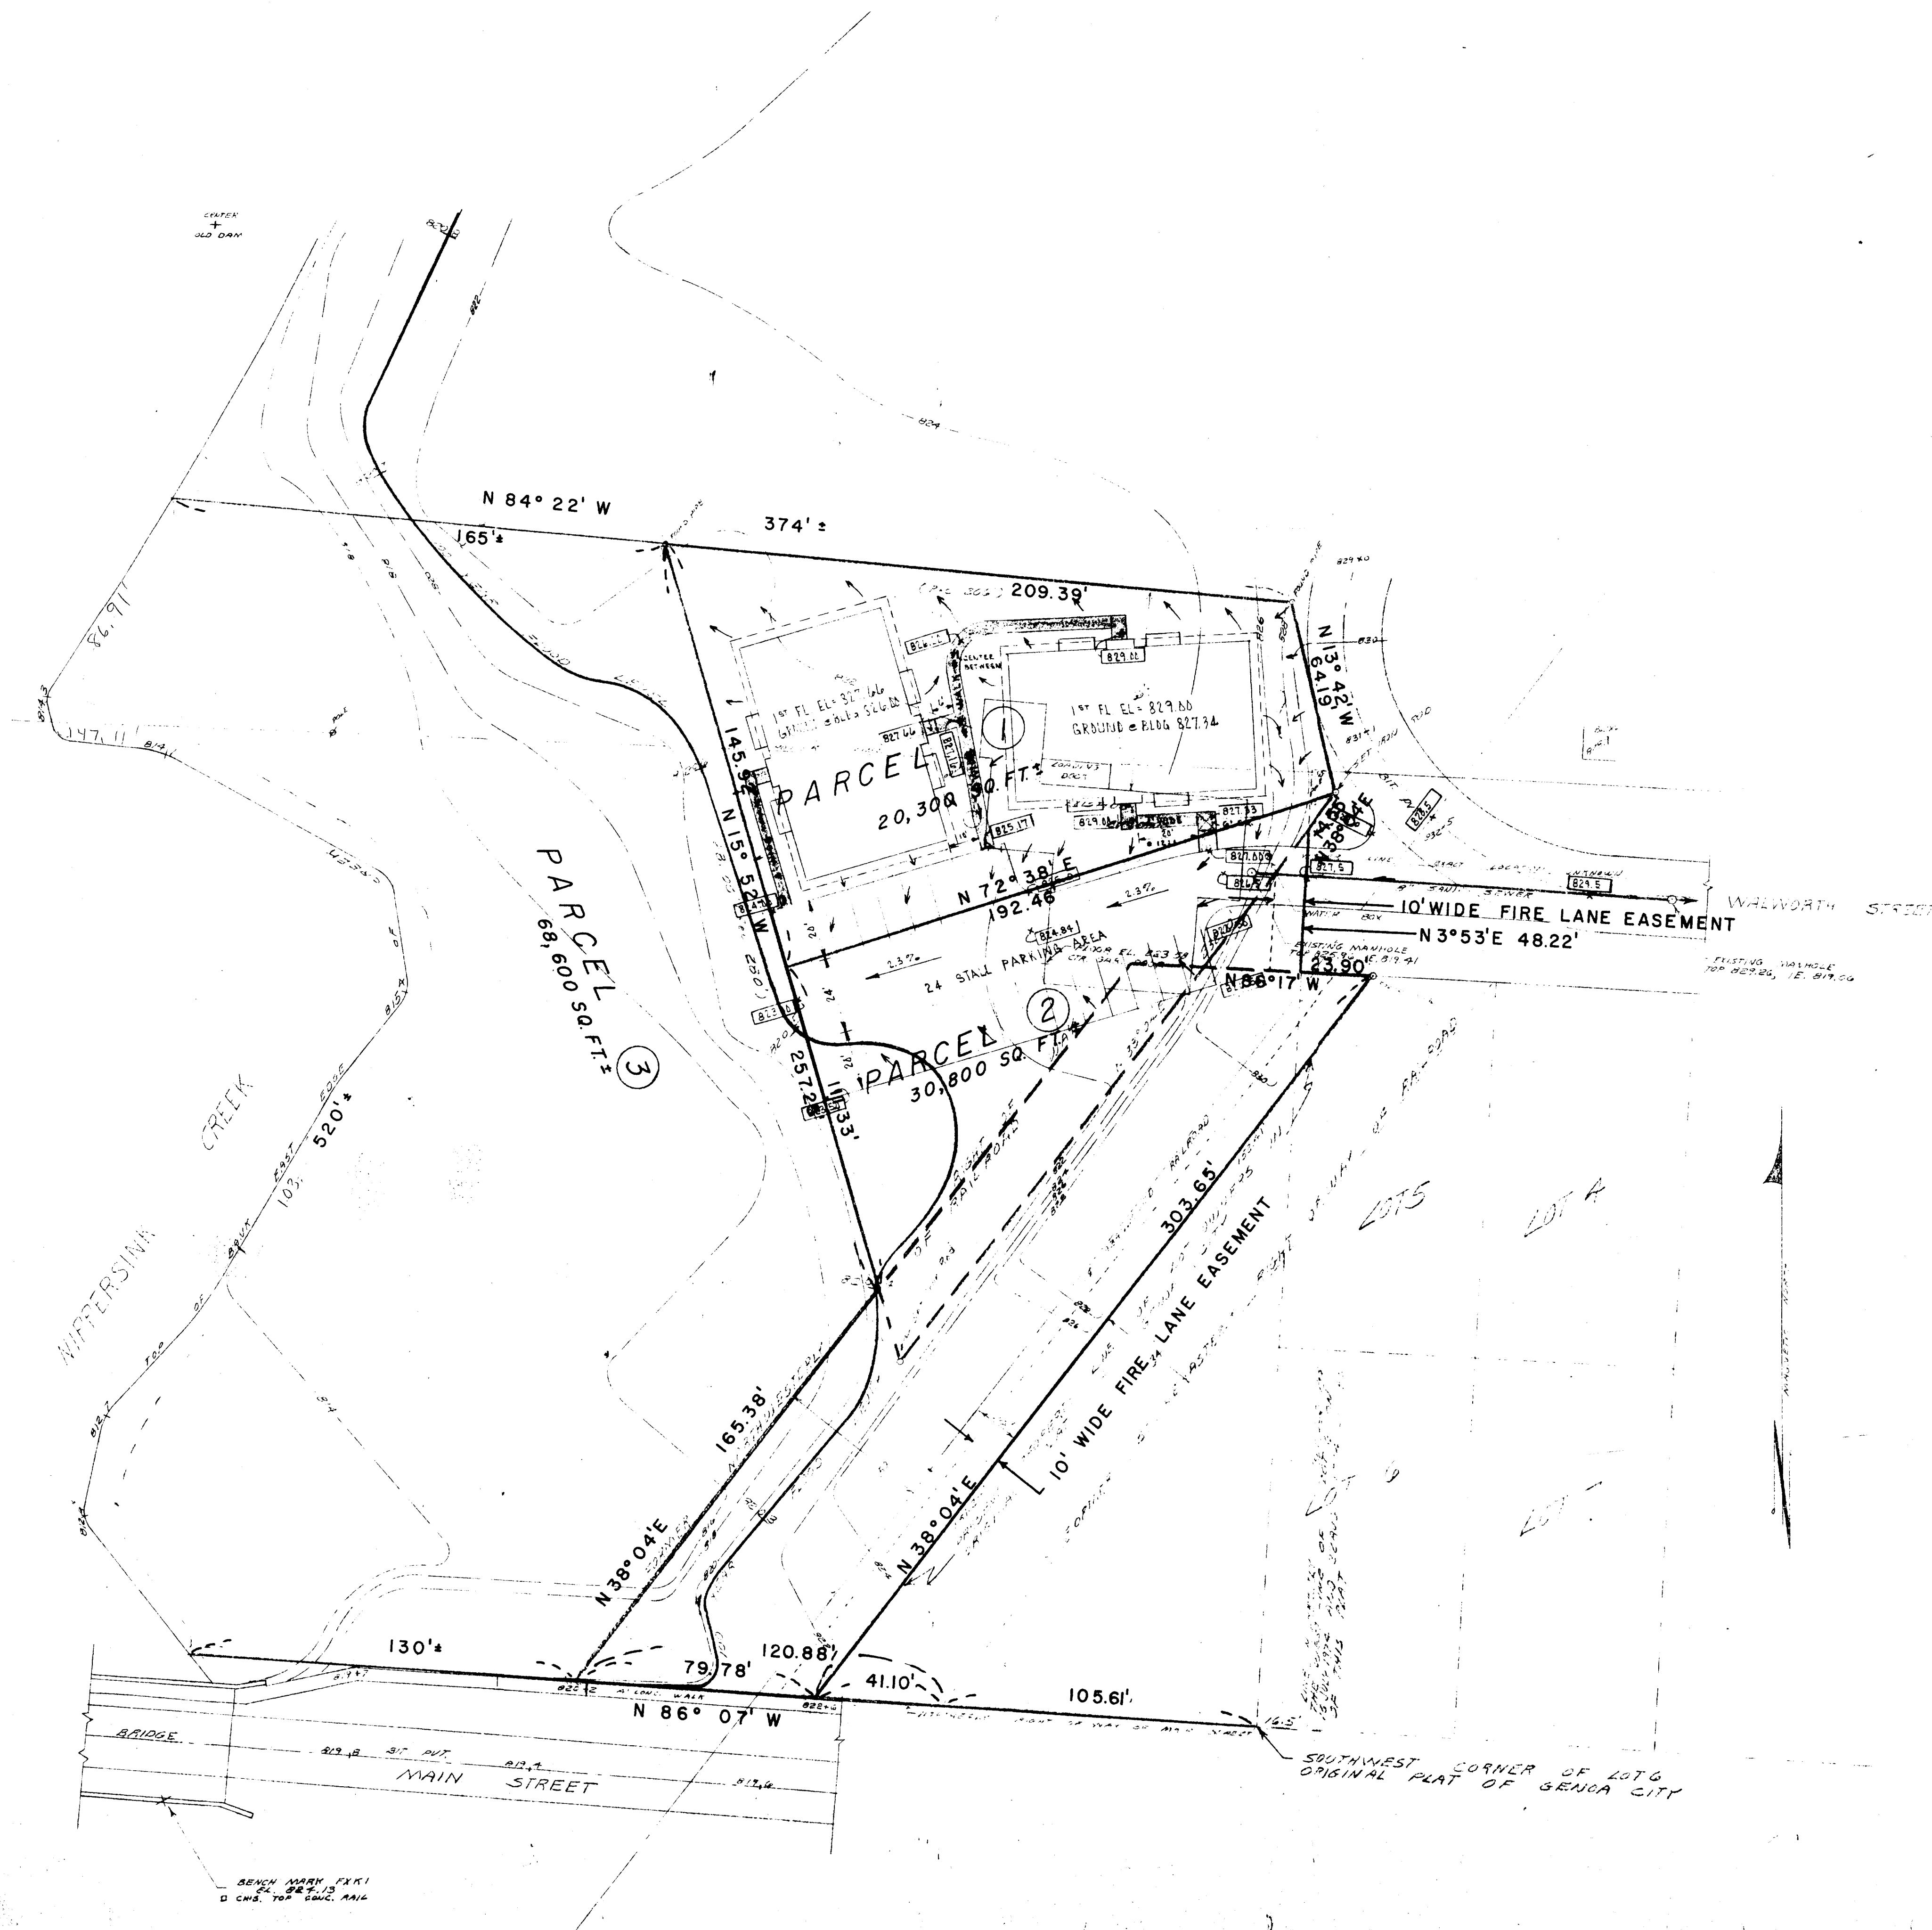

REVISED GRADING & SIDEWALK PLAN
WALTER TURNER
OCT 23 1975 B.L.L.V.

Revised 31 July 1975

TOPOGRAPHIC SURVEY OF LAND NEAR FORMER GIBBS ICE CREAM COMPANY, GENOA CITY FOR WALTER J. TURNER LOCATED IN THE SOUTHEAST 1/4 OF SEC. 35, T.1N., R.18E, GENOA CITY, WALWORTH COUNTY, WISCONSIN		
DRAWN BY R.A.F.	JENSEN & JOHNSON CIVIL ENGINEERS ELKHORN, WIS.	SCALE: 1 INCH = 30 FEET
CHECKED BY [Signature]	DATE 16 JULY 1974	REVISION 22 AUG. 1974
APPROVED BY [Signature]		SHEET NO. THREE OF

