


HAROLD H. KOLB

REGISTERED PROFESSIONAL LAND SURVEYOR
LAKE GENEVA, WISCONSIN

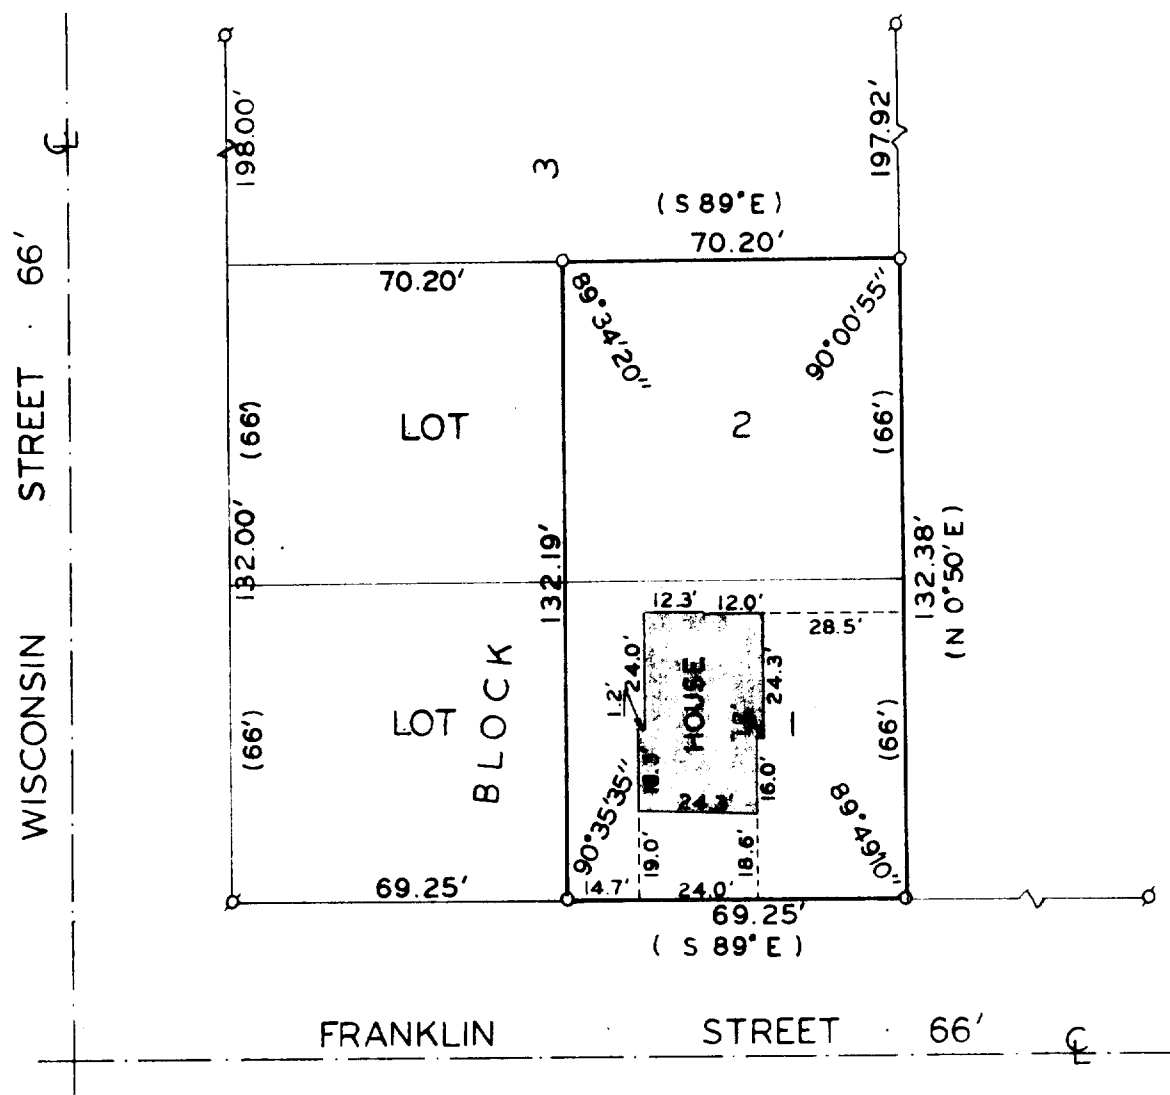

PLAT OF SURVEY OF

EAST 1/2 OF LOTS 1 AND 2, BLOCK 3,
GIFFORDS ADDITION TO THE VILLAGE OF
GENOA CITY, WALWORTH COUNTY, WISCONSIN.

OWNER: DENIS M. BUCH

ACCURACY: DISTANCES $\pm 0.01'$
ANGLES $\pm 05''$

ERROR OF CLOSURE - LESS THAN
ONE PART IN 3000



SCALE 1" = 40'

LEGEND

- O — IRON PIPE PLACED, 1" x 24" 1.13 LB./LIN. FT.
- — CONCRETE MONUMENT, 5" DIA. x 30"
- Ø — IRON PIPE FOUND
- () — AS PLATTED

Harold H. Kolb

HAROLD H. KOLB
WISCONSIN REGISTERED LAND SURVEYOR, S-187

DATE *March 6, 1917*

6-83