ENGINEERING, ARCHITECTURE, SURVEYING
7 RIDGEWAY COURT - P.O. BOX 437, ELKHORN, WISCONSIN, 53121

PHONE: (414) 723–2098 FAX: (414) 723–5886


## PLAT OF SURVEY

## LOT 91 OF HUNTERS RIDGE SUBDIVISION

LOCATED IN ALL 1/4'S OF THE SW 1/4
SECTION 25, TOWN 1 NORTH, RANGE 18 EAST
VILLAGE OF GENOA CITY, WALWORTH COUNTY, WISCONSIN

PROJECT 4267.91

SHEET 1 OF 1

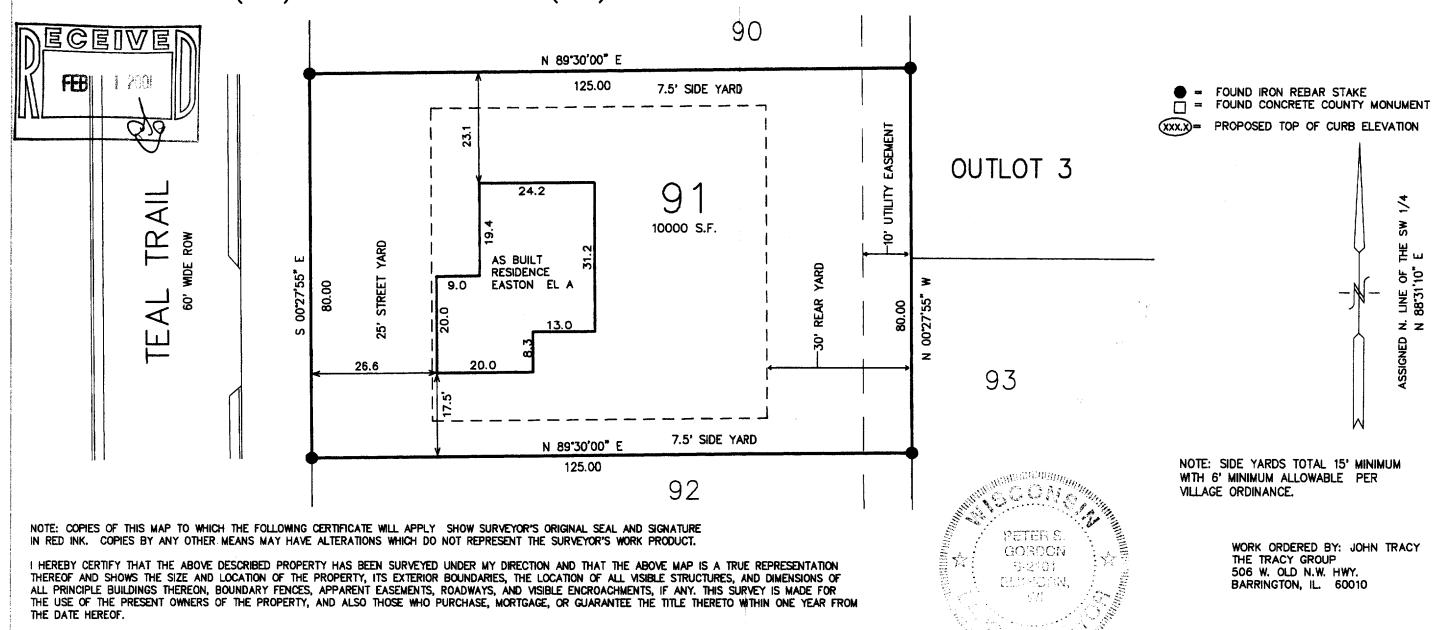

10 5 0

MAP SCALE IN FEET ORIGINAL 1'' = 20'

DEC 1 3 30%

THR-91

DATED: 09-25-00

PETER S. GORDON R.L.S. 2101

PP8-2007

RESIDENCE AS BUILT

REVISED 12-19-2000TO SHOW SIZE & LOCATION OF