
## PLAT OF SURVEY -OF-

LOT 2, BLOCK 7, FREEMAN'S SECOND ADDITION, VILLAGE OF GENOA CITY, WALWORTH COUNTY, WSCONSIN.

SURVEY FOR: CENTURY 21, LARRY HODGES REALTY

SURVEY LOCATION: 328 SUMNER STREET

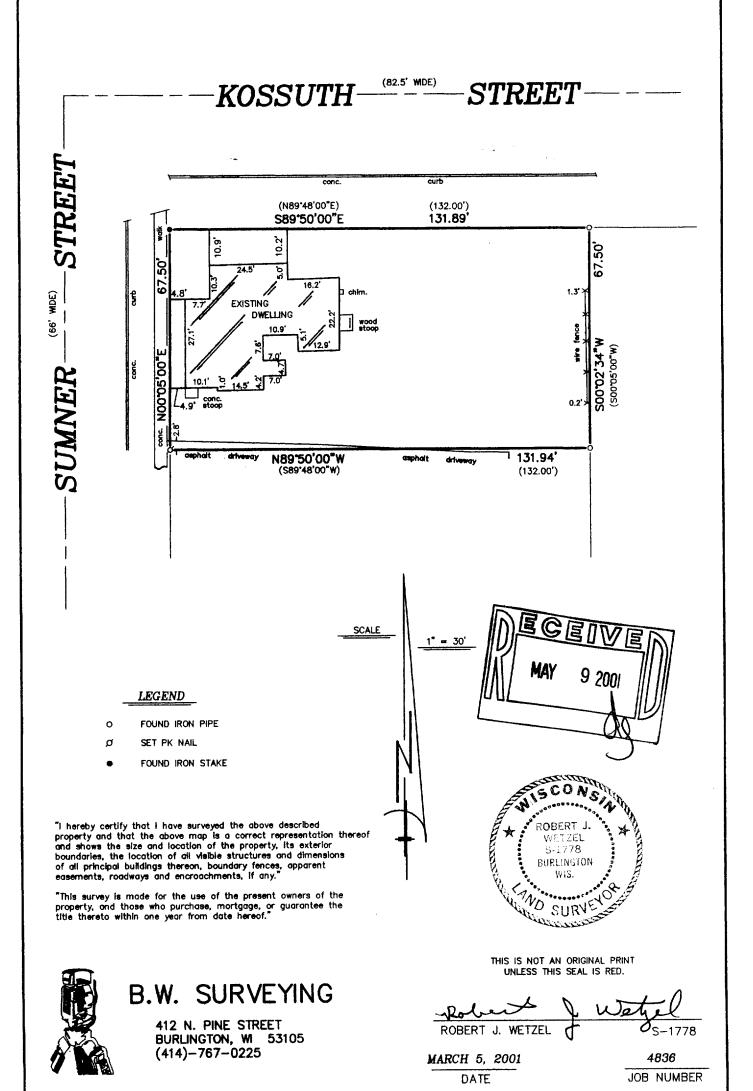

TFR2-26

088-000