

# DEGEN, FOAT SURVEYING ASSOCIATES


100 SOUTH SECOND STREET  
WATERFORD, WISCONSIN  
(262)534-5404 (FAX)534-2022

015308  
015308S1.DWG

## PLAT OF SURVEY

LOT 68, RIDGEVIEW SUBDIVISION, LOCATED IN PART OF THE NORTHWEST 1/4, NORTHEAST 1/4 AND SOUTHEAST 1/4 OF THE SOUTHWEST 1/4 OF SECTION 35, TOWN 1 NORTH, RANGE 18 EAST, VILLAGE OF GENOA CITY, WALWORTH COUNTY, WISCONSIN.

SURVEY PREPARED FOR: DEBBIE SARNA  
RE/MAX - SOUTHERN LAKES  
112 ELIZABETH LANE  
GENOA CITY, WI 53128

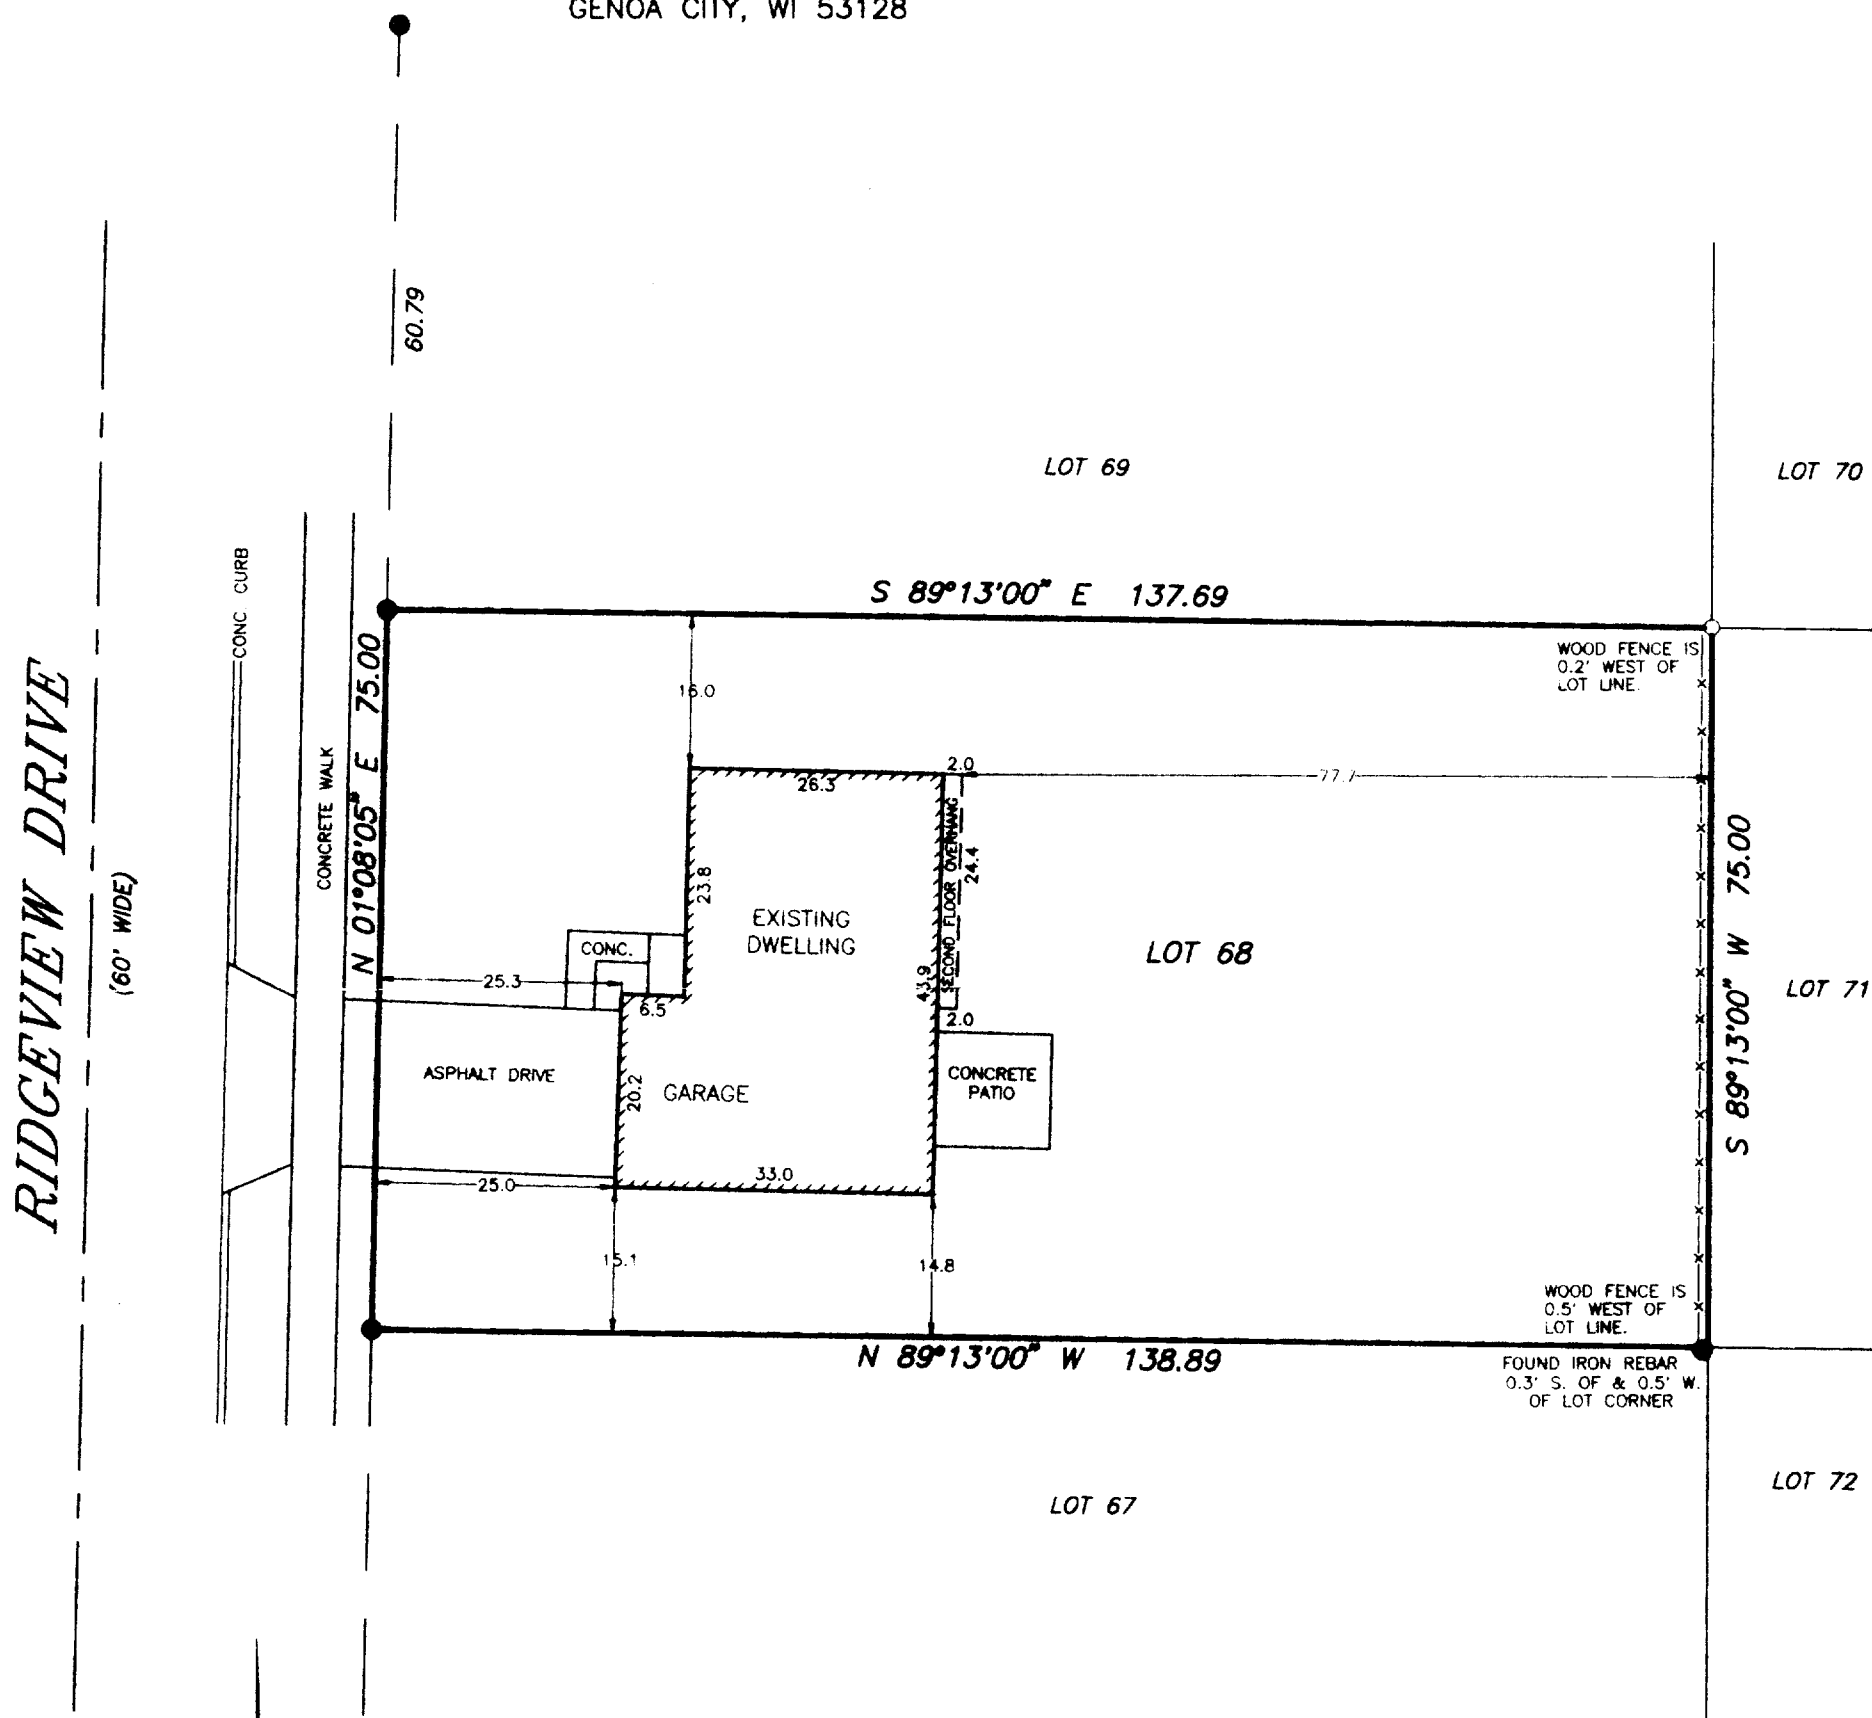

SCALE: 1" = 20'

BEARING BASE: AS RECORDED AS

### LEGEND


- - FOUND SOLID IRON BAR
- - SET IRON PIPE
- FENCE
- ( ) - RECORDED AS

I HEREBY CERTIFY THAT I HAVE SURVEYED THE ABOVE DESCRIBED PROPERTY AND THE ABOVE MAP IS A TRUE REPRESENTATION THEREOF AND SHOWS THE SIZE AND LOCATION OF THE PROPERTY, THE LOCATION OF ALL VISIBLE STRUCTURES AND DIMENSIONS OF ALL PRINCIPAL BUILDINGS THEREON, BOUNDARY FENCES, APPARENT EASEMENTS, ROADWAY AND VISIBLE ENCROACHMENTS, IF ANY.

THIS SURVEY IS MADE FOR THE PRESENT OWNERS OF THE PROPERTY, AND ALSO THOSE WHO PURCHASE, OR GUARANTEE THE TITLE THERETO WITHIN (1) YEAR FROM THE DATE HEREOF.

DATED AT WATERFORD, WI THIS 5th DAY OF NOVEMBER 2001

RECERTIFIED

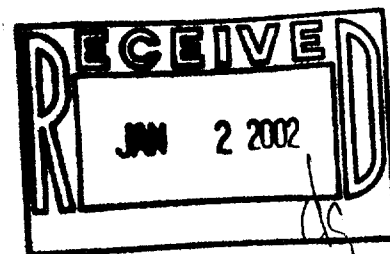

TR10-68  
006-968