


DESCRIPTION:

Lot 5, Zarnstorff Subdivision of a portion of Genoa City,
Walworth County, Wisconsin.

CERTIFICATE:

I, James F. Biagi, surveyor, hereby certify that I have surveyed
the property hereon as shown and the location of the improvements
are as shown.

May 23rd 1963.

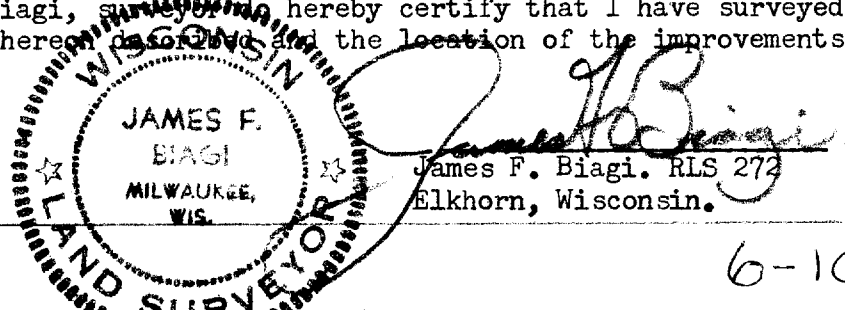

6-10B