



PLAT OF SURVEY

of Lot 3 of MILLER'S ADDITION TO GENOA JUNCTION, being a subdivision located in the Northeast Quarter of Section 35, Township 1 North, Range 18 East of the 4th Principal Meridian, lying and being in the Village of Genoa City, Walworth County, Wisconsin.

AMBIT LAND SURVEYING
 P.O. Box 42
 Bassett, WI. 53101
 414-537-4874

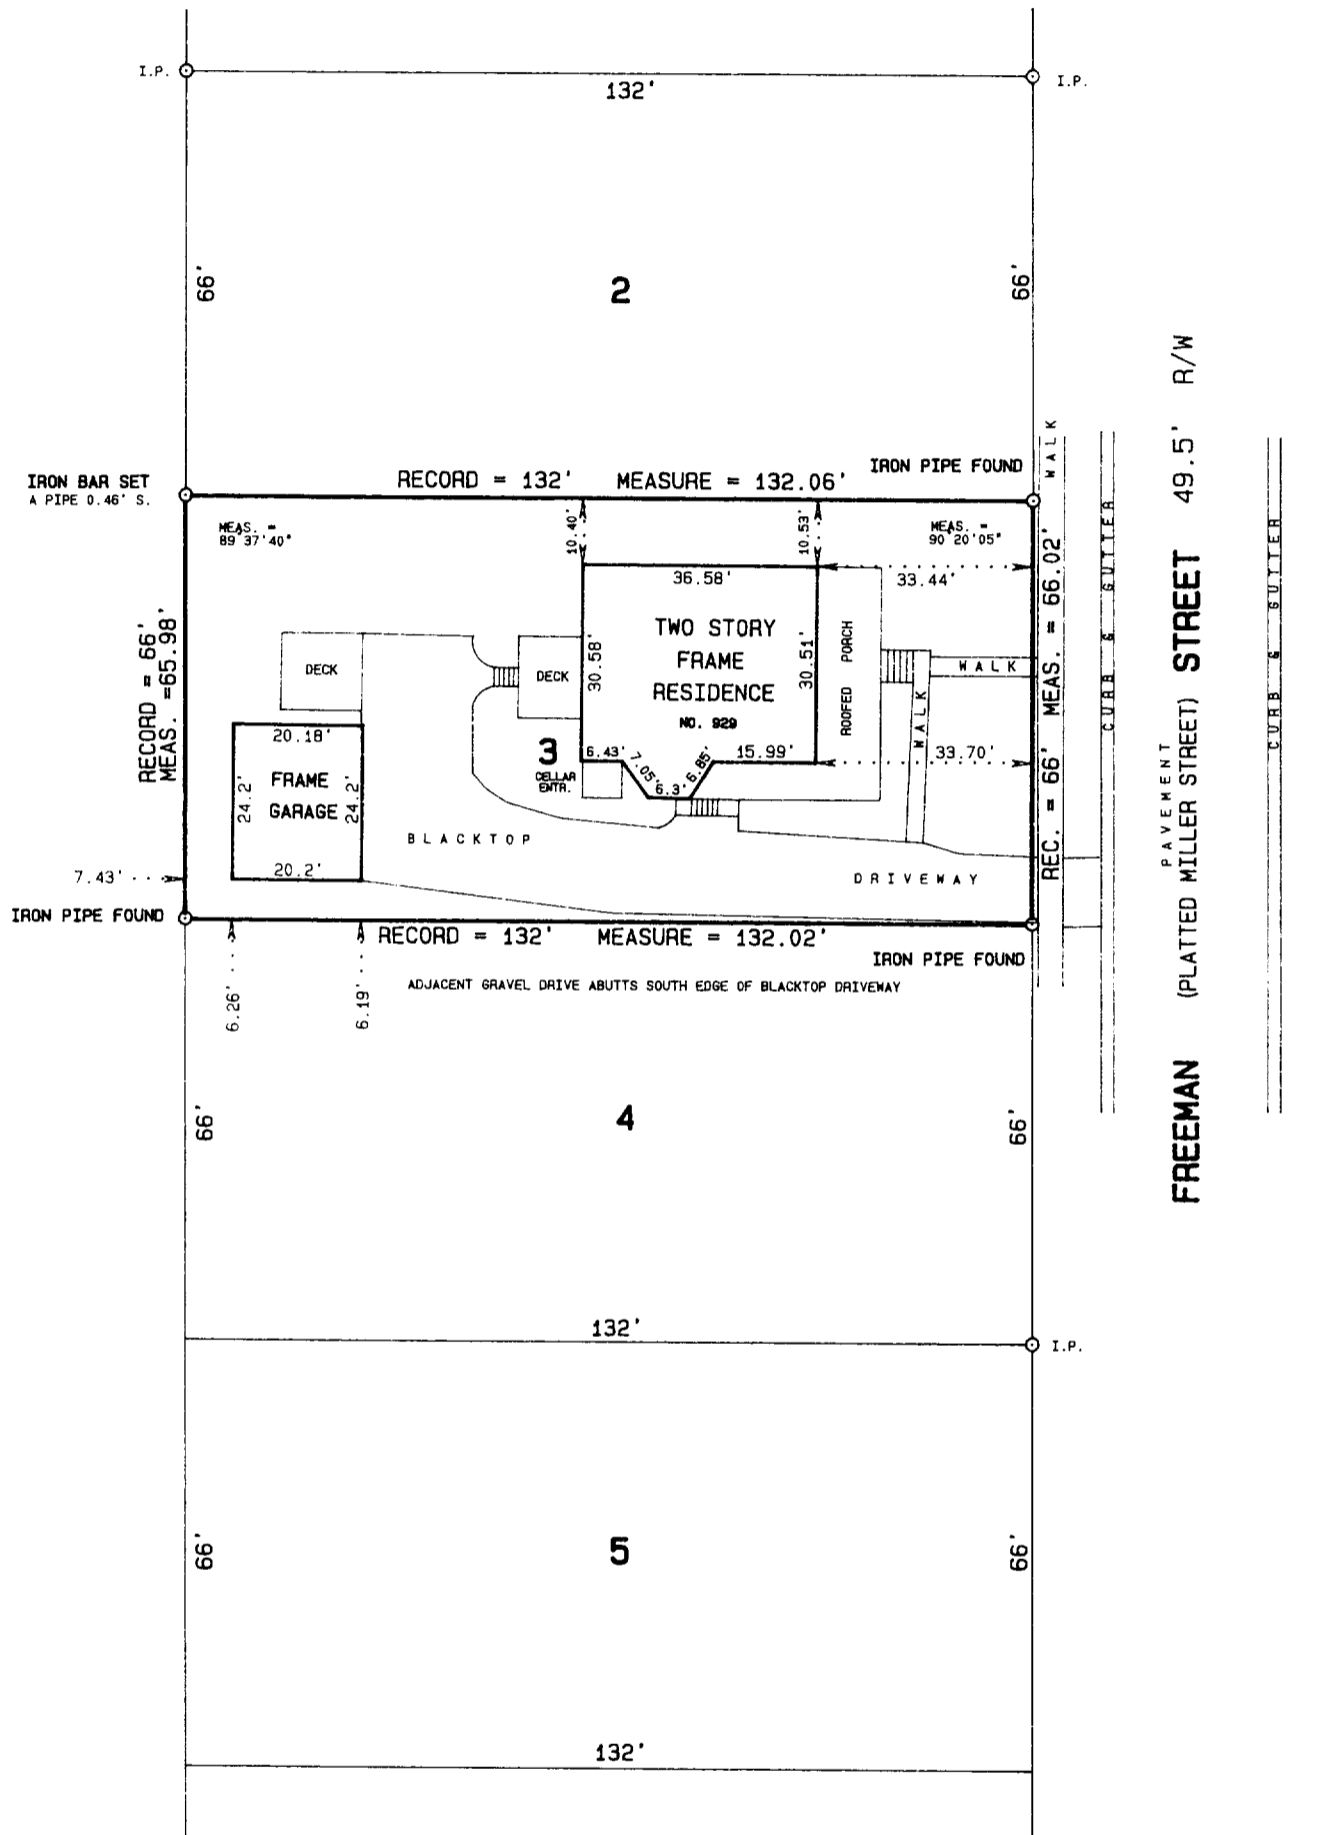

FREEMAN (PLATTED MILLER STREET) STREET 49.5' R/W
 PAVEMENT
 CURB & GUTTER
 CURB & GUTTER

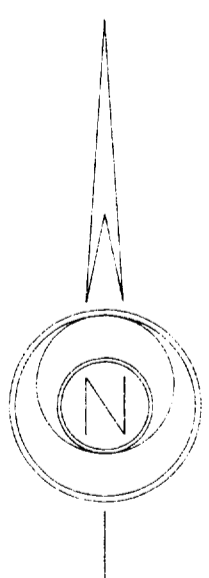


SCALE 1 inch = 30 feet
 ORDERED BY A. Prejna/REMAX Plaz
 JOB NO. 93073

I hereby certify that I have surveyed the above described property and the above plat is a true representation thereof and shows the size and location of the property, its exterior boundaries, the location and dimensions of all visible structures thereon, boundary fences, apparent easements and roadways and visible encroachments, if any.

This survey is made for the exclusive use of the present owners of the property, and also those who purchase, mortgage, or guarantee the title thereto within one year from the date hereof.

Dated at Bassett, Wisconsin this 20th day of MARCH 1993.

Mark A. Bolender
 Mark A. Bolender
 Wisconsin Registered Land Surveyor S - 1784

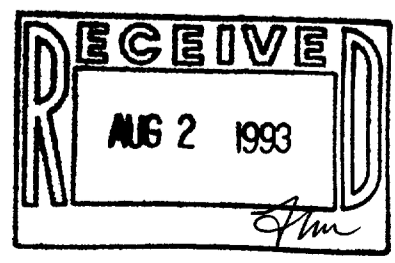

TMA-3

006-306