

DEGEN, FOAT SURVEYING ASSOCIATES

982201  
982201S1.DWG


100 SOUTH SECOND STREET  
WATERFORD, WISCONSIN  
(414)534-5404 (FAX)534-2022

PLAT OF SURVEY

LOT 4, ZARNSTORFF ADDITION, LOCATED IN THE SOUTHEAST 1/4 OF THE SOUTHEAST 1/4 OF SECTION 35, TOWN 1 NORTH, RANGE 18 EAST OF THE FOURTH PRINCIPAL MERIDIAN, VILLAGE OF GENOA CITY, COUNTY OF WALWORTH, STATE OF WISCONSIN.

SURVEYED ORDERED BY: BARBARA GOODNOUGH  
CENTURY 21-ZENK REALTY  
100 ELIZABETH LANE  
GENOA CITY, WISCONSIN 53128


MAIN STREET  
(66' WIDE)

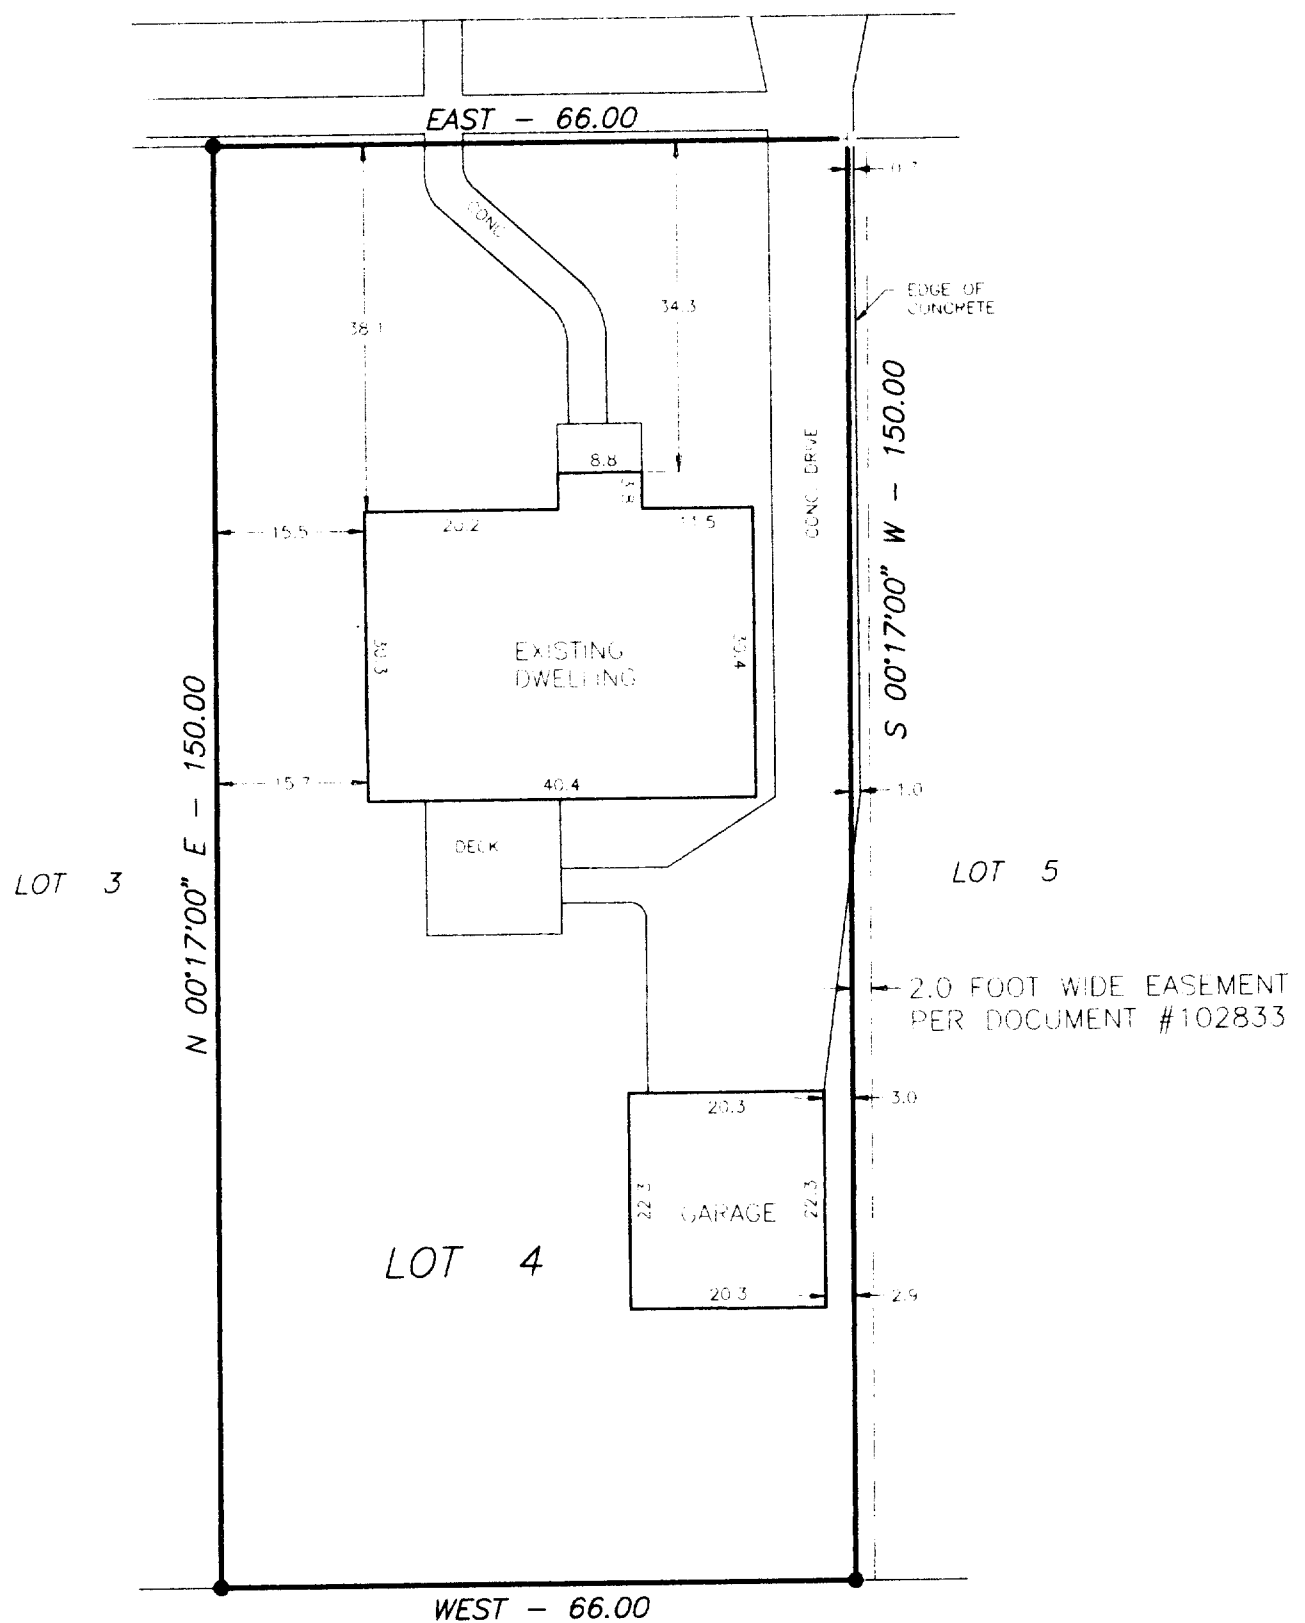

SCALE: 1" = 20'

LEGEND

- + - CROSS SET IN CONCRETE
- o - PK NAIL
- - FOUND IRON PIPE
- - SET IRON PIPE
- ( ) - RECORDED AS

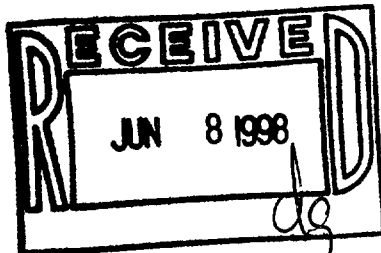

I HEREBY CERTIFY THAT I HAVE SURVEYED THE ABOVE DESCRIBED PROPERTY AND THE ABOVE MAP IS A TRUE REPRESENTATION THEREOF AND SHOWS THE SIZE AND LOCATION OF THE PROPERTY, THE LOCATION OF ALL VISIBLE STRUCTURES AND DIMENSIONS OF ALL PRINCIPAL BUILDINGS THEREON, BOUNDARY FENCES, APPARENT EASEMENTS, ROADWAY AND VISIBLE ENCROACHMENTS, IF ANY.

THIS SURVEY IS MADE FOR THE PRESENT OWNERS OF THE PROPERTY, AND ALSO THOSE WHO PURCHASE, OR GUARANTEE THE TITLE THERETO WITHIN (1) YEAR FROM THE DATE HEREOF

DATED AT WATERFORD THIS 20TH DAY OF MAY 1998

RECERTIFIED

*James B. Foat*

006-528

TSZ-4