


LOT 9 AND THE EAST 1/2 OF LOT 10 BLOCK
2 OF STRAIN'S ADD., VILLAGE OF GENOA
CITY, WALWORTH COUNTY, WISCONSIN.

**Engineers & Surveyors
Elkhorn , Wisc.
414-723-3204**

Bearings referenced to center line of Wisconsin St. assumed bearing $N0^{\circ}-34'-00''E$.

William A. Shearman
William A. Shearman S-1378
Registered Land Surveyor

Dated this 25th day of August, 1977.

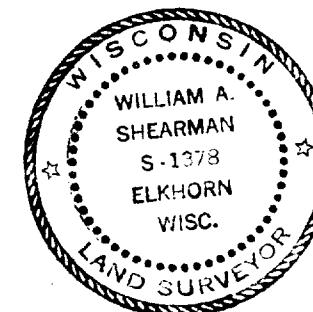

- 1" Iron pipe found.
- 2" Iron pipe found.
- Spike found.
- 3/4"x24" Iron rod weighing 1.50 lbs./lin ft. set.

SURVEYED FOR A. RUEHLMAN
PO. 1658.189