


PREPARED FOR : SANDRA FORST
PO. BOX 833
GENOA CITY WI. 53128

PLAT OF SURVEY
OF

J.K. SURVEYING INC.
N3705 WILLOWBEND LANE
LAKE GENEVA, WI, 53147
262-248-3697

LOT 6, BLOCK 7, FREEMANS SECOND ADDITION TO THE VILLAGE OF GENOA (NOW
GENOA CITY), WALWORTH COUNTY, WISCONSIN.

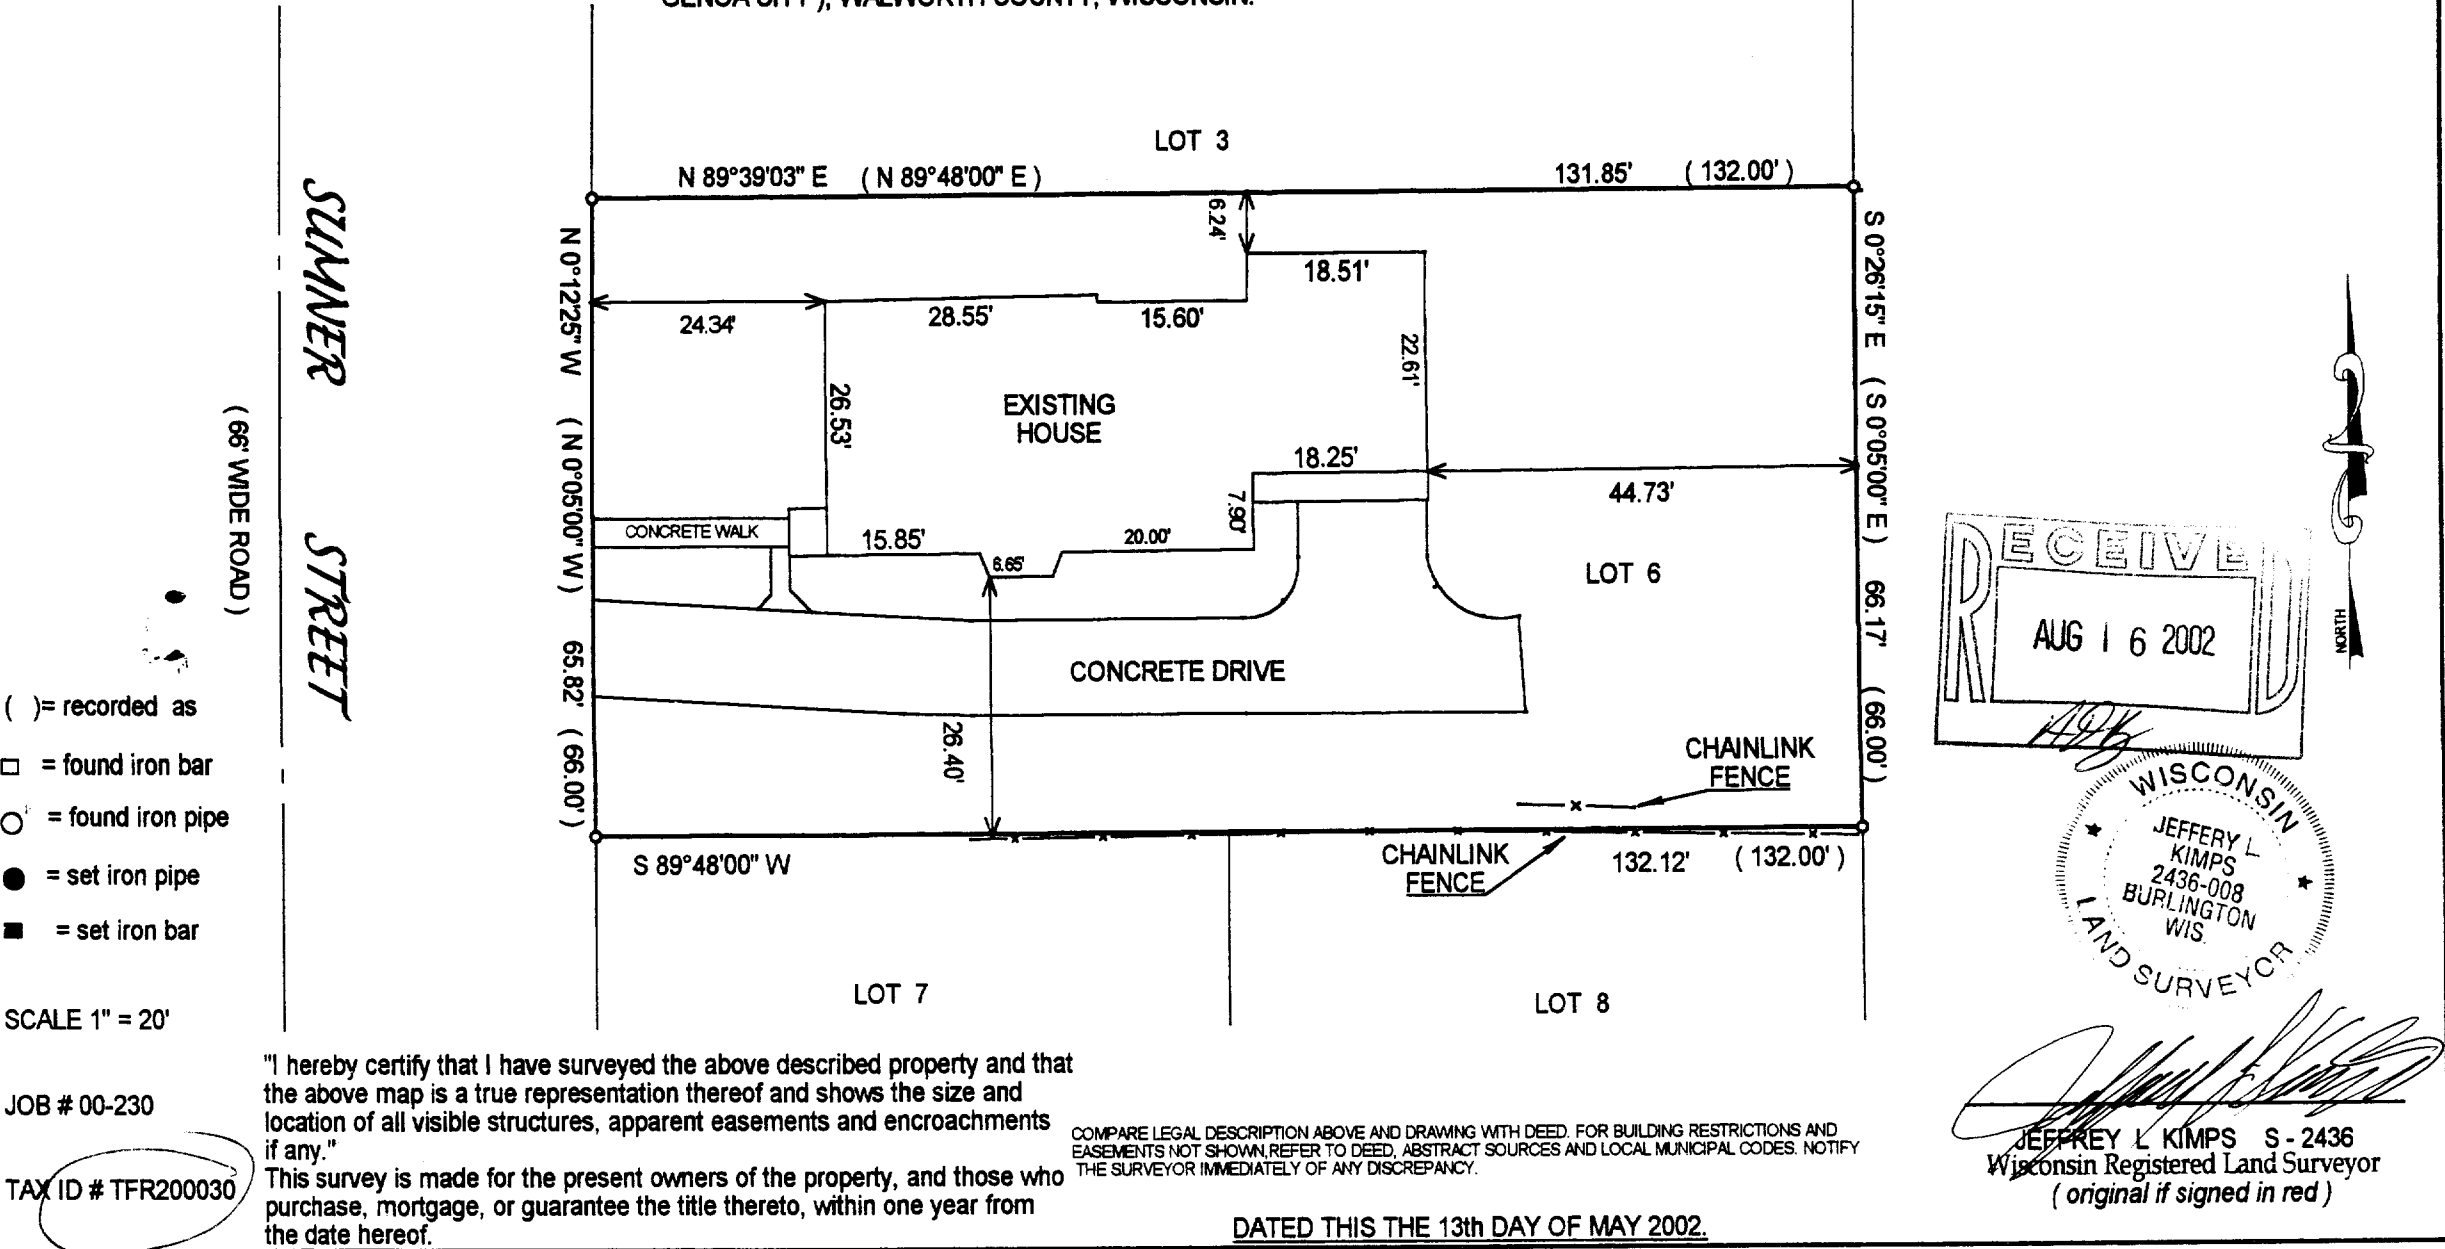

6-1045