

PREPARED FOR : LINDA ARANDA  
PO. BOX 515  
GENOA CITY WI. 53128


# PLAT OF SURVEY

- OF -

J.K. SURVEYING INC.  
N3705 WILLOWBEND LANE  
LAKE GENEVA, WI, 53147  
262-248-3697



EAST 1/2 OF LOTS 1 AND 2, BLOCK 3, GIFFORD'S ADDITION TO THE  
VILLAGE OF GENOA, WALWORTH COUNTY, WISCONSIN.  
RECORDED IN VOLUME 307, PAGE 549 IN WALWORTH COUNTY  
REGISTER OF DEEDS.

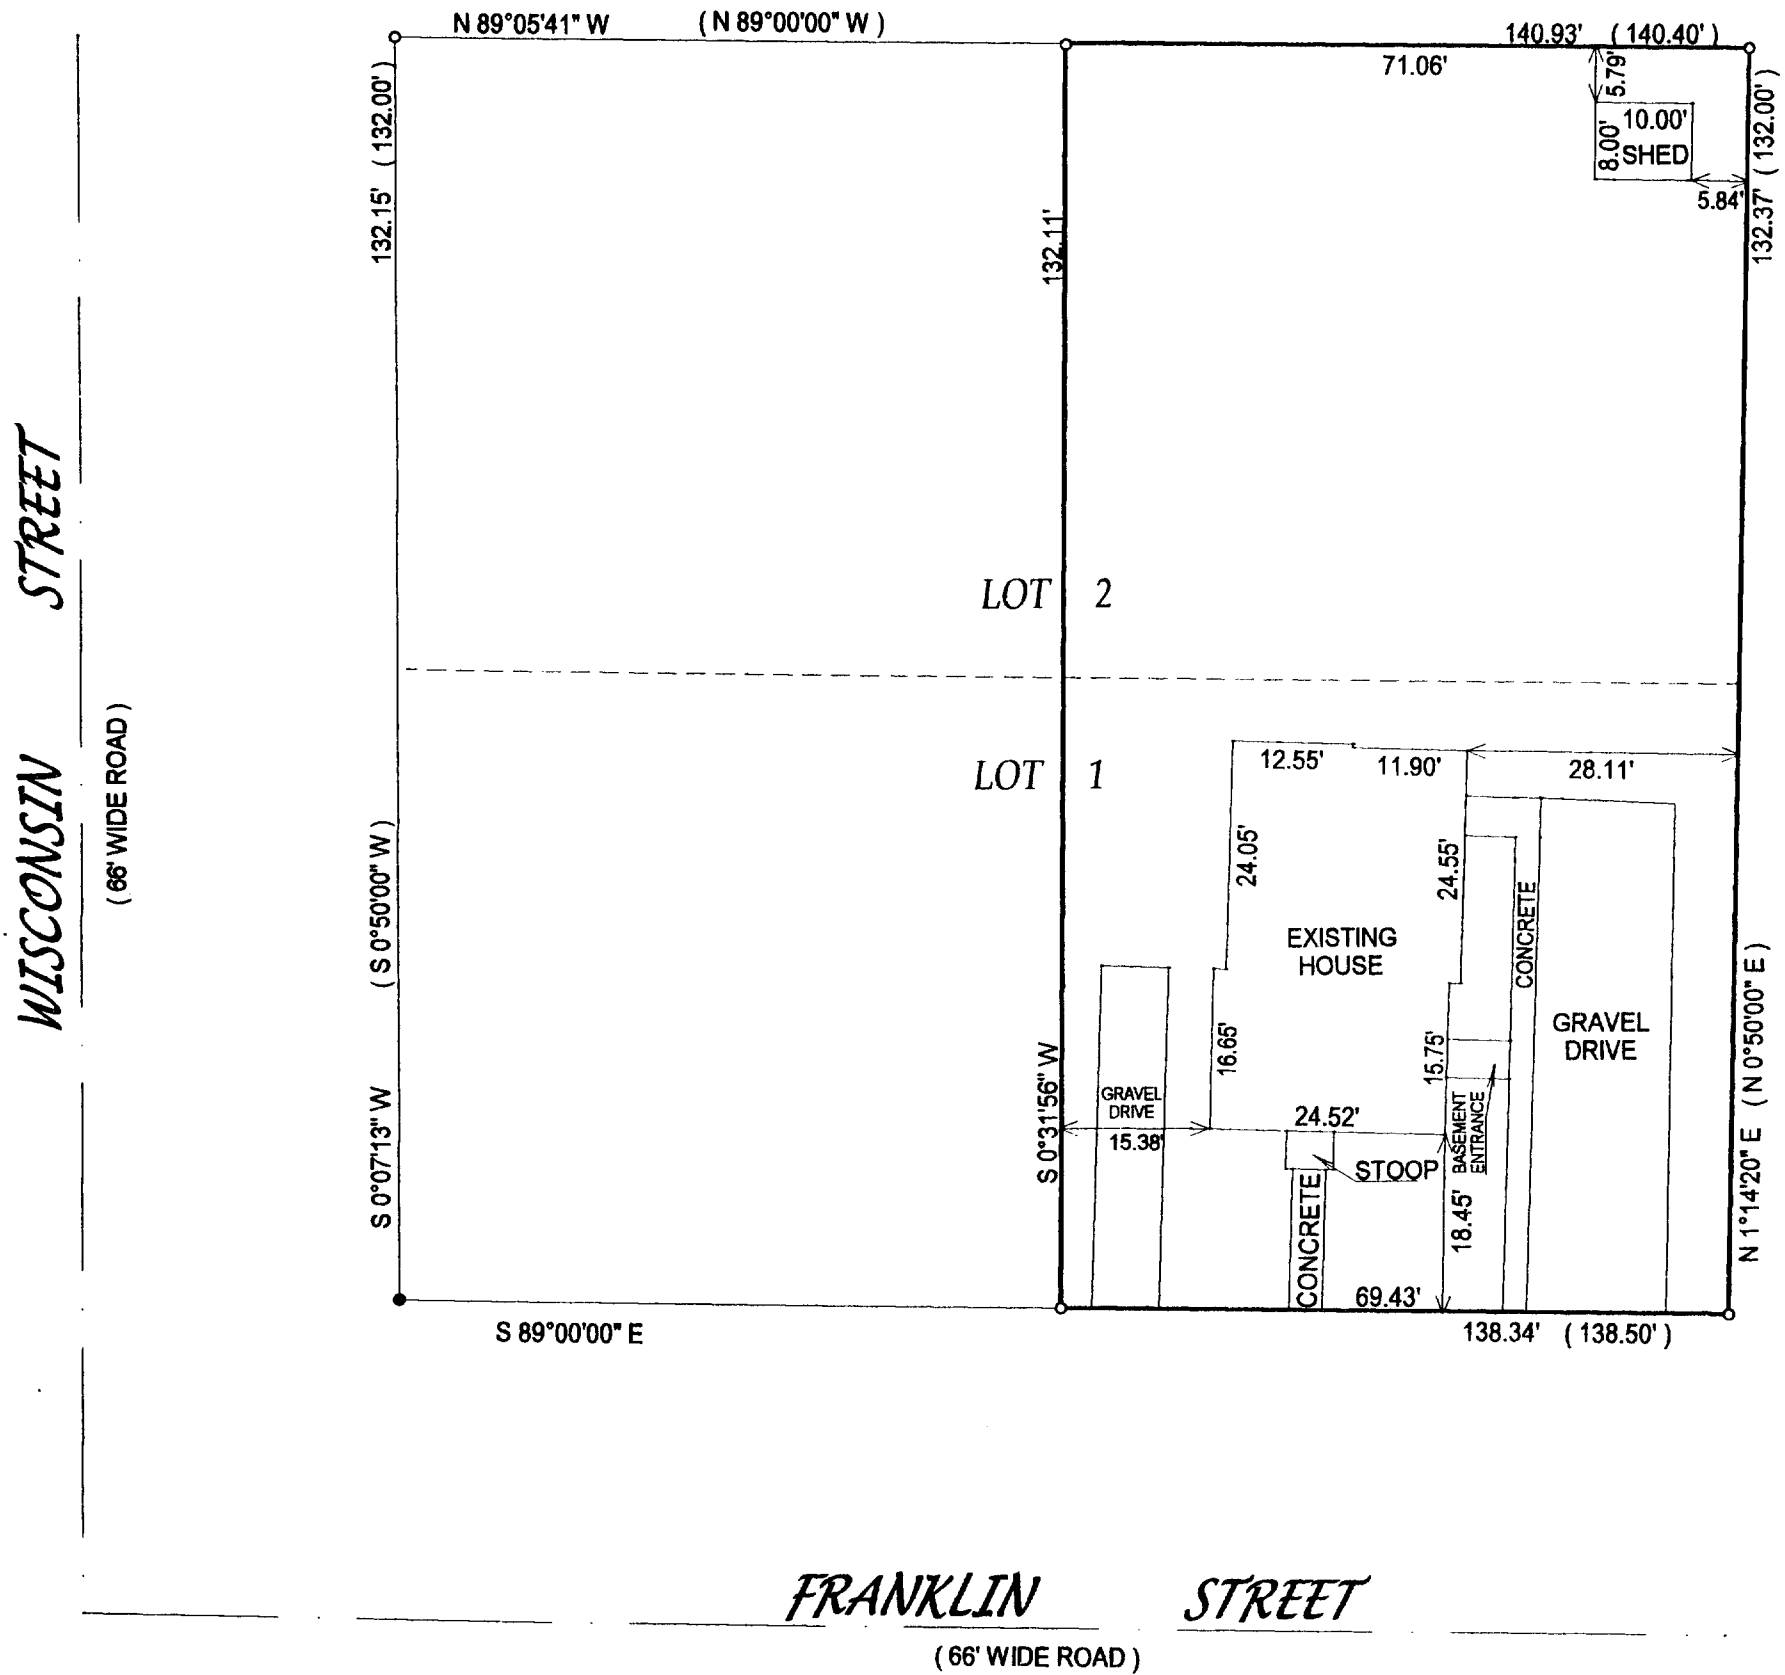

- ( ) = recorded as
- = found iron bar
- = found iron pipe
- = set iron pipe
- = set iron bar

SCALE 1" = 20'

JOB # 02-211



TAX ID # TG0002 ○ A

COMPARE LEGAL DESCRIPTION ABOVE AND DRAWING WITH DEED. FOR BUILDING RESTRICTIONS AND EASEMENTS NOT SHOWN, REFER TO DEED, ABSTRACT SOURCES AND LOCAL MUNICIPAL CODES. NOTIFY THE SURVEYOR IMMEDIATELY OF ANY DISCREPANCY.

"I hereby certify that I have surveyed the above described property and that the above map is a true representation thereof and shows the size and location of all visible structures, apparent easements and encroachments if any."

This survey is made for the present owners of the property, and those who purchase, mortgage, or guarantee the title thereto, within one year from the date hereof.

DATED THIS THE 21st DAY OF MAY 2002.

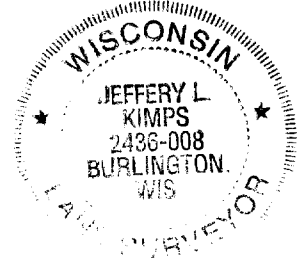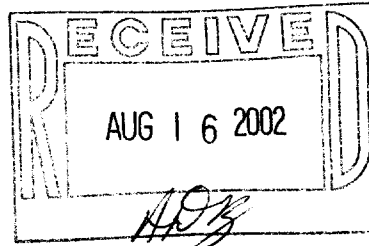

JEFFREY L. KIMPS S - 2436  
Wisconsin Registered Land Surveyor  
(original if signed in red)

6-1047